

Pawnee


KANSAS

SECTION 8 TOWNSHIP 23 RANGE 17 WT

WELL NO. #6 J. Schartz

COMPANY Hilton Drlg.

NORTH

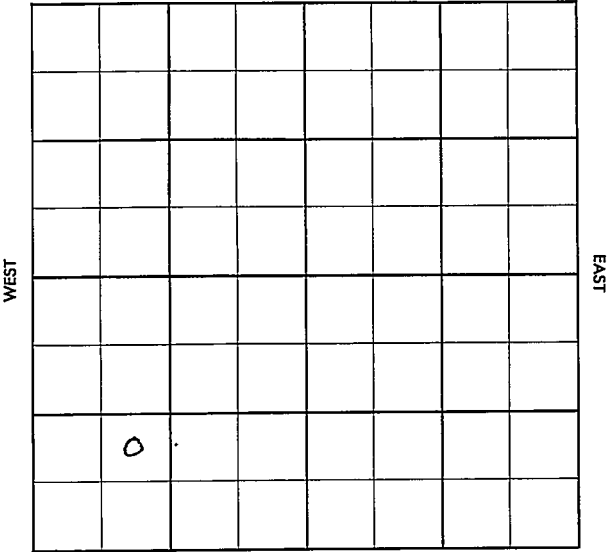

SOUTH

Pawnee

KANSAS

SEC.	TWP.	R.
8	23	17W

WELL NO. #6 J. Schartz FARM

COMPANY Hilton Drlg.

CONTRACTOR Co Tools


Garfield

_____ Ft. from N. Line

_____ Ft. from S. Line

_____ Ft. from E. Line

_____ Ft. from W. Line

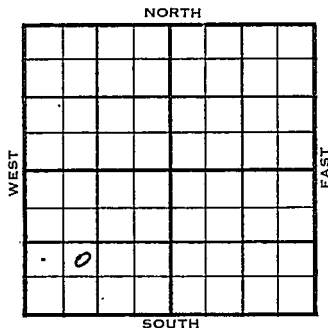

NE SW SW

1955

ELEVATION
2094'

REPORT

10/26

Loc

12-7

Comm. 10-29-55
 8 5/8" @ 215/200
 DST 4217-30 op 1 hr. 40 min. gas in 2
 min., rec. 4150' oil, 1060/20"
 5 1/2" @ 4323,
 CO 60/ 4219-29, frac
 F/ 18 BOPH
 Comp. 252 bopd
 H. 3663
 BL 3769
 KC 3778
 SHly 4202
 Cq. Cher. 4216
 Mz. 4288
 TD 4325.

COMPLETED

County Paulsbee Elev. _____
 Sec. 8 Twp. 23 Rge. 17W
 Company Hilton Drlg.
 Farm Name J. Schartz No. 6

TOPS	DEPTH	LOG	DATUM
Anh.			
Tp.			
H.			
Tr.			
Dg.			
Bl.			
L.			
K.C.			
B.K.C.			
Ce.			
C.			
M.			
M.			
K.			
Mz.			
Mq.			
V.			
S.			
S.			
A.			
R.			
Pe.			
G.			
T.D.			

Loc. in Sec. NE SW SW

Geol. _____
 Contr. Co. tools

Pool Garfield

FIRST REPORT
 OCT 26 '55

Date Comm. _____
 Location Location

[Handwritten signature]

Co.

Loc.

No.

Sec.

T.

R.

County Pawnee Elev. 2094
 Sec. 8 Twp. 23 Rge. 17W
 Company Hilton Drlg.
 FarmName J. Schartz No. 6

TOPS	DEPTH	LOG	DATUM	Loc. in Sec.
Anh.				
Tr.				<u>NE SW SW</u>
H.	<u>3663</u>		<u>1569</u>	
Tr.				
Dg.				
Bl.	<u>3769</u>		<u>1675</u>	
L.				
K.C.	<u>3778</u>		<u>1689</u>	Geol. _____
B.K.C.				Contr. _____
Ce.				Co. tools _____
C. <u>561V</u>	<u>4202</u>		<u>2108</u>	Pool _____
M. <u>19/8her</u>	<u>4216</u>		<u>2122</u>	<u>Garfield</u>
M.				
K.				
Mz.	<u>4288</u>		<u>2194</u>	
Mq.				
V.				
S.				
S.				
A.				
R.				
PE.				
G.				
TR.	<u>4325</u>			

COMPLETED

Date Comm. 10-29-55 DEC 7 1955

8 5/8" @ 215/200 DST 4217-30 open

1 hr. 40 min. gas in 2 min. rec.

1150' oil 1060/20" 5 1/8" @ 4323 CO

60/ 4219-29 frac F/ 18 boph

Comp. 252 bopd