

Section 8 Township 23 Range 17WWell No. #3 L.J. SchartzCompany Hilton Drlg.

NORTH

WEST

EAST

				0	.		

SOUTH

15

Pawnee KANSAS

SEC.	TWP.	R.
8	23	17W

WELL NO.

3 L. J. Schartz

FARM

COMPANY

Hilton Drlg.

CONTRACTOR

Hilton drlg.


Garfield Pool

_____ Ft. from N. Line

330 _____ Ft. from S. Line

_____ Ft. from E. Line

330 _____ Ft. from W. Line

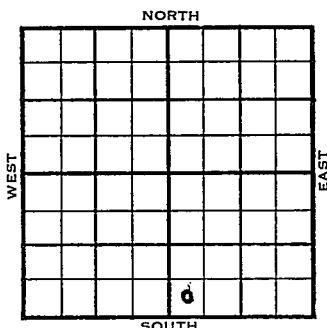

SW SW SE

1954	ELEVATION	REPORT
	2109'	

5/19
5/26
6/2
6/9
6/23
6/30
7/21


Location

"
"
"
"
"

Spud 6-12-54 Oil well TD 4347
8" @ 240 Heeb 3676 Br. lime 3784
Lans. 3792 B KC 4153 Cong 4216
Miss 4257
DST 4254-70 open 1 hr gas in 23 min,
rec 335' free oil, 1382#
Meisner 4283' Viola 4330'
TD 4347 5" @ 4346 CO to 4330
36/4285-91 5 GW sd-frac 200 MA
S/20 BOPH ~~KKS~~ 40% wtr. 3 hr.
Comp. 215 BOPD 12% wtr.

COMPLETED

County Pawnee State Kansas
 Sec. 8 (Blk. 23) (Sur. 17W) Map No. 17W
 Operator Hilton Drlg.
 Well No. 3 Farm L. J. Scharzt
 Elev. 2109 Location SW SW SE

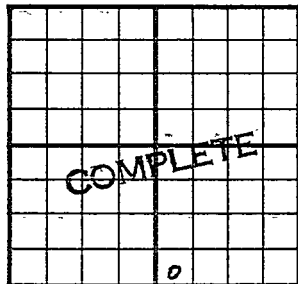

330 Ft. From S Line SE
330 Ft. From W Line Quarter

Ist. Report

Completion JUL 21 1952

Remarks Garfield Pool

Hilton Drlg. - Contr.

Spudding Date 6-12-54

Drlg. Data Oil well TD 4347
8" @ 240 Heeb. 3676 Br. lime 3784
Lans. 3792 B KC 4153 Cong. 4216
Miss. 4257 DST 4254-70 open 1 hr.
gas in 23 min. Rec. 335' free oil
1382# Meisner 4283 Viola 4330
TD 4347 5" @ 4346 CO to 4330
36/ 4285-91 5 gw sd-frac 200 M-A
S/ 20 boph 40% wtr. 3 hr.
Comp. 215 bopd 12% wtr.

J. G. McGEHEE