


Pawnee KANSAS

DX 78-1

Section 8 Township 23 Range 17W

Well No. 4 L. J. Schartz

Company Hilton Drig.

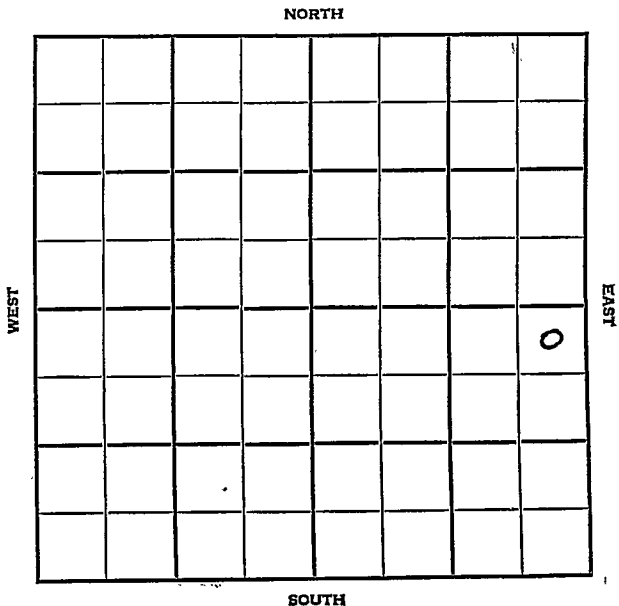

Pawnee

SEC. TWP. KANSAS

WELL NO. 8 23 17 W

4 L. J. Schartz FARM

COMPANY

Hilton Drlg.

CONTRACTOR

Garfield Pool


330 Ft. from N. Line

Ft. from S. Line

330 Ft. from E. Line

Ft. from W. Line

NE NE SE

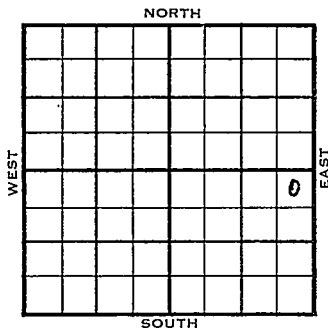

	ELEVATION	REPORT
1954	2089'	

7/14, Spud 7-9-54
8" @ 223
Drlg. 1800'

7/21 drlg. 3985'

8/18 Spud 7-9-54 Oil well TD 4354
8" @ 223 Heeb 3659 Br. lime 3762
KC 3771 Miss 4241
DST 4257-90 open 1 hr rec 230' oil
50' OCM 1165# Misener 4268'
Viola 4333 TD 4354 5" @ 4351 CO
36/4226-32 sd-oil-frac F/22 BOPH
Gong. 4223' Comp. BHB 1336 BOPD

COMPLETED

