

Pawnee

KANSAS

SECTION 8 TOWNSHIP 23 RANGE 17 W

WELL NO. #10 L. J. Schartz

COMPANY Hilton Drlg.

NORTH

| | | | | | | | |
|--|--|--|--|--|--|--|--|
| | | | | | | | |
| | | | | | | | |
10

WEST

EAST

0

SOUTH

Pawnee

KANSAS

| | | |
|------|------|-----|
| SEC. | TWP. | R. |
| 8 | 23 | 17W |

WELL NO.

#10 L. J. Scharz

FARM

COMPANY

Hilton Drlg

CONTRACTOR

Co Tools

Garfield


_____ Ft. from N. Line

_____ Ft. from S. Line

_____ Ft. from E. Line

_____ Ft. from W. Line

SE NW SE

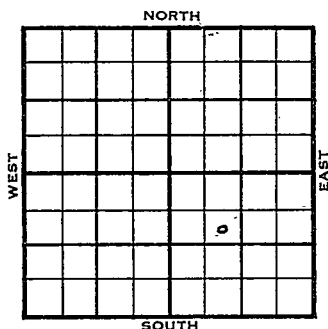

| | ELEVATION | REPORT |
|-------|---|--------|
| 1955 | 2091 ### | |
| 11/16 | Comm 11-12-55 8" @ 216/200 Drlg 1375 | |
| 1956 | | |
| 1-18 | DST 4200-18 op 2 hrs. gas in 51 min. rec rec 65' gcm, 1060/30" DST 4220-38 op 1 hr. rec. 150' mud, 23 130/30" 5 1/2" @ 4286 CO to 4268, 60/ 4224-34, frac, 2 3/4 boph 10% wtr., 40/ 4224-34, Comp. 40 bopd, 30% wtr. BL. 3754 KC 3764 C. ShaLey 4184 Cg. Chert 4207 M. 4222 #.Mz. 4244 TD 4288' | |

COMPLETED

County Paynee Elev. 2091
 Sec. 8 Twp. 23 Rge. 17W
 Company Hilton Drlg.
 FarmName L. J. Schartz No. 10

| TOPS | DEPTH | LOG | DATUM | Loc. in Sec. |
|--------------------|-------------|-----|-------------|--------------|
| Anh. | | | | SE NW SE |
| Tr. | | | | |
| H. | | | | |
| Tr. | | | | |
| Dg. | | | | |
| BL. | <u>3754</u> | | <u>1663</u> | |
| L. | | | | |
| K.C. | <u>3764</u> | | <u>1673</u> | Geol. |
| B.K.C. | | | | Contr. |
| Ce. | | | | |
| C. <u>shales</u> | <u>4184</u> | | <u>2093</u> | Co. tools |
| M. <u>of chert</u> | <u>4207</u> | | <u>2116</u> | |
| M. | <u>4222</u> | | <u>2131</u> | Pool |
| K. | | | | |
| Mz. | <u>4244</u> | | <u>2153</u> | Garfield |
| Ma. | | | | |
| V. | | | | |
| S. | | | | |
| S. | | | | |
| A. | | | | |
| R. | | | | |
| PE. | | | | |
| G. | | | | |
| T.D. | <u>4288</u> | | | |

COMPLETE

Date Comm. 11-12-55 JAN 18 19568" @ 216/200 DST 4200-18 open 2 hr.gas in 15 min. rec. 65' gcm 1060/30"DST 4220-38 open 1 hr. rec. 150' mud130/30" 5 1/2" @ 4286 CO to 426860/ 4224-34 frac 2 1/4 boph 10% wtr.40/ 4224-34 Comp. 40 bopd 30% wtr.