


Pawnee **KANSAS**

SECTION 8 TOWNSHIP 23 RANGE 17 W

WELL NO. #11 L. J. Scharz

COMPANY Hilton Drlg.

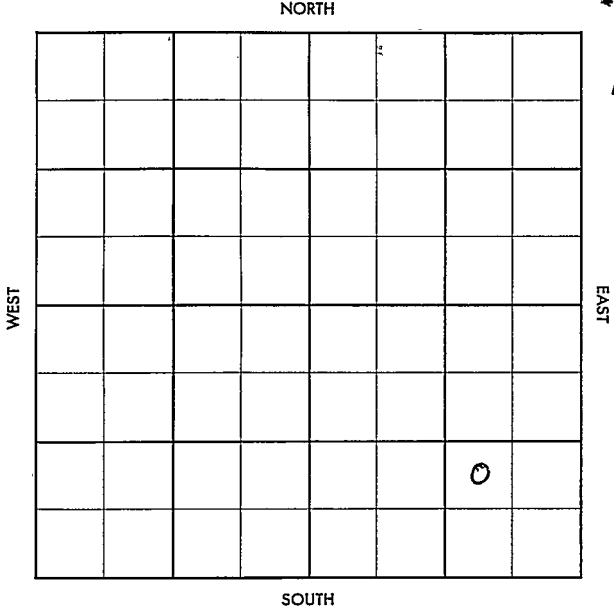

County Paynee Elev. _____
 Sec. 8 Twp. 23 Rge. 17W
 Company Hilton Drlg.
 Farm Name L. J. Schartz No. 11

TOPS	DEPTH	LOG	DATUM
Anh.			
Tr.			
H.			
Tr.			
Dg.			
BL.			
L.			
K.C.			
B.K.C.			
Ce.			
C.			
M.			
M.			
K.			
Mz.			
Me.			
V.			
S.			
S.			
A			
R.			
PE			
G.			
T.D.			

Loc. in Sec. NW SE SE

Geol. _____
 Contr. _____
 Co. tools _____

Pool Garfield

NOV 30 '55
 FIRST REPORT

Date Comm. M I R

Co.

Lse.

No.

Sec.

T.

R.

County Paynee Elev. 2100
 Sec. 8 Twp. 23 Rge. 17W
 Company Hilton Drlg.
 Farm Name L. J. Schartz No. 11

TOPS	DEPTH	LOG	DATUM	Loc. in Sec.
Anh.				NW SE SE
Tr.				
H.	3666			
Tr.				
Dg.				
Bl.	3768			
L.				
K.C.	3776		1676	Geol.
B.K.C.				Contr.
Ce.				
C. <i>shaley</i>	4203		2103	Co. tools
M. <i>cong. ch.</i>	4223		2123	
M.	4244		2144	Phal
K.				Garfield
Mz.	4316		2216	
Me.				
V.	4342		2242	
S.				
S.				
A				
R.				
PE.				
G.				
T.D.	4344			

COMPLETE

Date Comm. 11-28-55 JAN 25 1956
 8 5/8" @ 222 DST 4225-39 open 1 hr.
 rec. 200' hocm 1090/30" DST 4244-64
 open 1 1/2 hr. gas to surface in 6 min.
 rec. 4150' free oil 1175/30" 5 1/2" @
 4342 GO to 4330 72/ 4245-53
 FU 45 bo 18 hr. frac S/ 13 1/2 bo
 2% wtr. 5 hr. Comp. 217 bopd