


Pawnee

**KANSAS**

SECTION 8 TOWNSHIP 23 RANGE 17W

WELL NO. #16 L.J. Schartz

COMPANY General American Oil

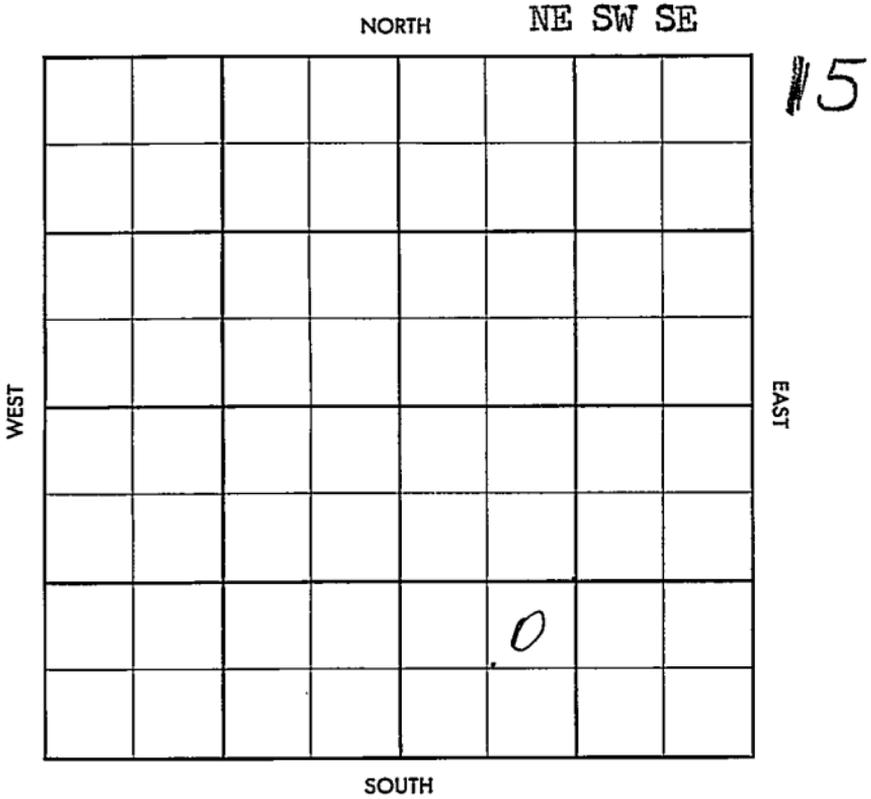

County Patnee Elev. \_\_\_\_\_  
 Sec. 8 Twp. 23 Rgs. 17W  
 Company General American Oil  
 Farm Name L. J. Schartz No. 16

TOPS	DEPTH	LOG	DATUM
Anh.			
Tp.			
H.			
Tr.			
Dg.			
Bl.			
L.			
K.C.			
B.K.C.			
Ce.			
C.			
M.			
M.			
K.			
Mz.			
Mo.			
V.			
S.			
S.			
A.			
R.			
PE.			
G.			
T.D.			

Loc. in Sec. \_\_\_\_\_  
NE SW SE  
 Geol. \_\_\_\_\_  
 Contr. Gabbert-Jones  
~~Publ.~~  
Garfield  


 FIRST REPORT  
 JUN 30 '57  
 0

Date Comm. \_\_\_\_\_  
Cellar & pits

\_\_\_\_\_

~~14~~

Co.  
 L.S.  
 No.  
 Sec.  
 T.  
 R.

County Pawnee Elev. 2110 DF  
 Sec. 8 Twp. 23 Rge. 17W  
 Company General American Oil  
 FarmName L. J. Scharzt No. 16

TOPS/	DEPTH	LOG	DATUM	Loc. in Sec.
Anh.				NE SW SE
Tp.				
H.		3678		
Tr.				
Dg.				
Bl.		3780		
L.		3788		
K.C.				Geol.
B.K.C.				Concr.
Ce.				Gabbert-Jones
C. <u>5 1/4</u>		4210		
M. <u>cherty c9</u>		4232		Garfield
M. <u>chert</u>		4270		
K.				
Mz. <u>sd</u>		4318		
Mo.				
V.		4334		
S.				
S.				
A.				
R.				
PE.				
G.				
T.D.	<u>4350</u>			

COMPLETE  
 APR 3 '57

Date Comm.

Cellar & pits FEB 6 '57 1-28-57

8 5/8 220/175 ID 3075 FEB 13 '57

DST 4233-65 90" 60' 50CM

BHP 630/1hr ID 4265 FEB '0 '57

5 1/2 4349/150 CO 4330

75/4230-42 +st 2 GW 1/4

Lost Part Ld. CO TO FVAC.

627'57 \$ 9 Boph no l/w T&R

Pop 6" 6 '57 Ph P. 136 Bopp + 2000

wh grav 370 414 13 57 MAR 27 '57