


DX 78-1 **Finney**

KANSAS

Section 8 Township 23 Range 32W

Well No. #1 Norton

Company Kansas-Nebraska

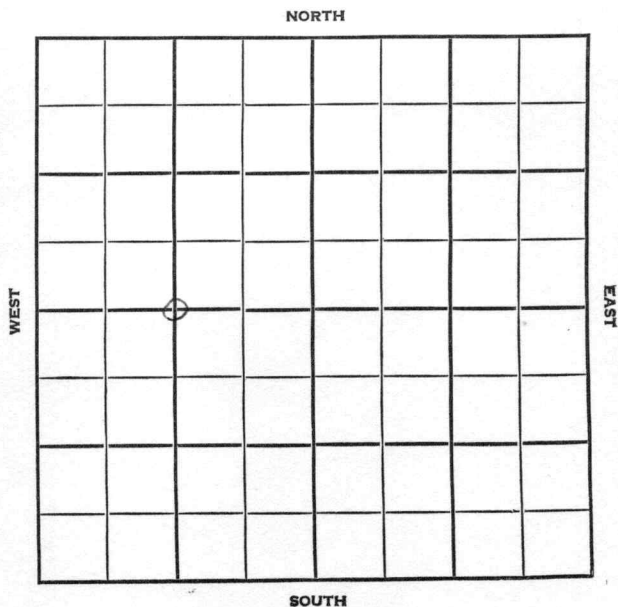

Finney

KANSAS

SEC.

8

TWP.

23

R.

32W

WELL NO.

#1 Norton

FARM

COMPANY

Kansas-Nebraska

CONTRACTOR


Hugoton

_____ FT. FROM N. LINE

_____ FT. FROM S. LINE

_____ FT. FROM E. LINE

_____ FT. FROM W. LINE

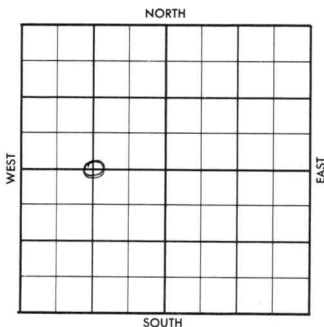C $W\frac{1}{2}$ of Sec.

1956

ELEVATION

REPORT

8-22

Comm. 8-8-56

COMPLETED

TOPS	DEPTH	LOG	DATUM	Loc. in Sec. _____
Anh.				C W ¹ / ₂ Sec.
Tr.				
H.				
Tr.				
Dg.				Geol. _____
BL.				
L.				
K.C.				
B.K.C.				Contr. _____
Ce.				
C.				
M.				
M.				Pool _____
K.				
Mz.				
Me.				
V.				Hugoton
S.				
S.				
A.				
R.				FIRST REPORT  AUG 22 1956
Pf.				
G.				

Date Comm. 8-8-56

Aug 5, 1928

Р.С.

Co.

County Finney Elev. 2857
Sec. 8 Twp. 23 Rge. 32W
Company Kansas-Nebraska
Farm Name Norton No. 1

Sec. 8 Twp. 23 Rge. 32W

Company Kansas-Nebraska

FarmName Norton No. 1

TOPS	DEPTH	LOG	DATUM	Loc. in Sec. _____
Anh. _____				C W ¹ Sec. _____
TP. <i>KFL</i>		<i>2543</i>		
H. <i>WFD</i>		<i>2608</i>		
Tr. _____				
Dg. _____				
Bl. _____				
L. _____				Geol. _____
K.C. _____				Contr. _____
B.K.C. _____				
Ce. _____				
C. _____				Pool _____
M. _____				<i>Hugoton</i>
M. _____				
K. _____				
Mz. _____				
Mo. _____				
V. _____				
S. _____				
S. _____				
A. _____				
R. _____				
PE. _____				
G. _____				
TD. _____	<i>2610</i>			COMPLETE

Use

No.

Sec.

1.

ス

Date Comm. 8-8-56 AUG 29 56 85/8 43,145

5 1/2 2609/200 DD2625 15

Frac ga 424 MCF + 35 Gwph

PB 2588 40/2544-54 88/2566

-P-8 SEP 5 56 FIVE 92 3.968 MCF

SEP 12 '56 ~~440~~ 7 CAMP S. L. GESSNER