


Section 8 Township 23 Range 33W

Well No. #1 Arthur Mayer

Company Northern Pump

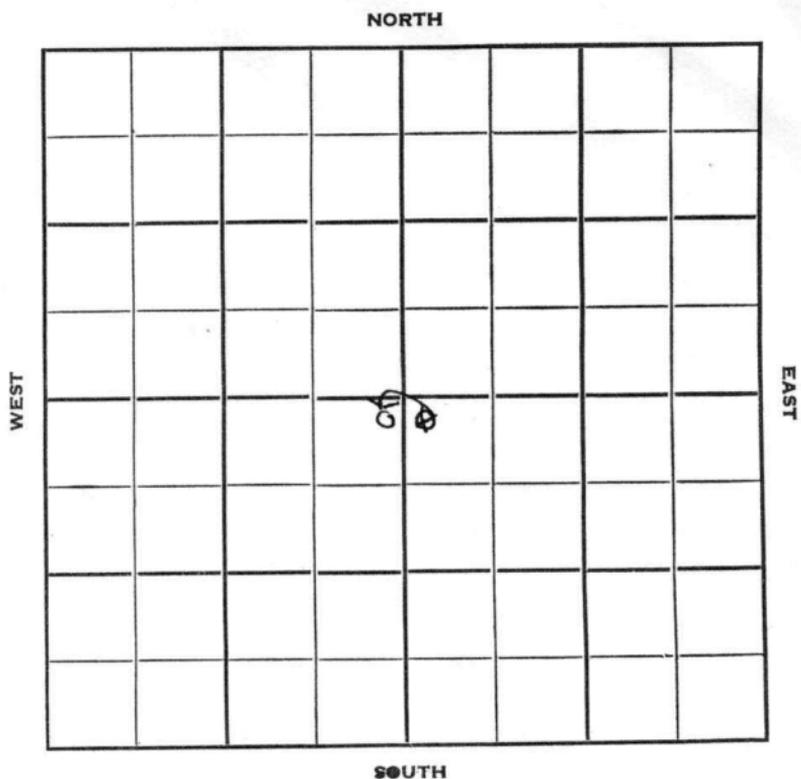

Sec. 8 Twp. Finney 23 R. 33W

Well No. #1 Arthur Mayer Farm

Northern Pump Company

Ben Brack - Contr. Contractor


150' Ft. from N. Line

\_\_\_\_\_ Ft. from S. Line

150 Ft. from E. Line

150' Ft. from W. Line

~~N E N E S W~~  
~~N W S E~~

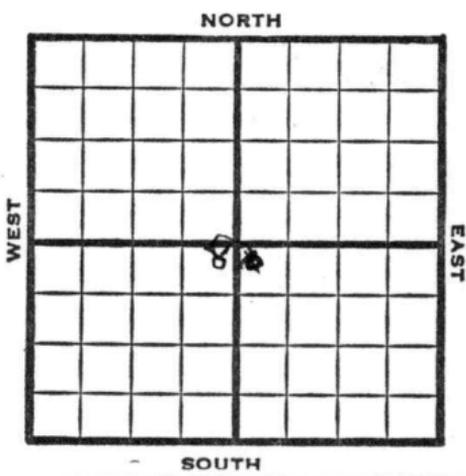

1952

Elev. 2903

REPORT

7/16

Spud 7-16-52  
10" @ 348  
Her 2552  
TD 2560

7/23

"

7/30

7" @ 2553'

8/6

DD 2598 1000 A

8/13

7000 A Winfield 2604'

8/20

TD 2626 23,000 A

8/27

Spud 7-16-52  
Gas Well TD 2626  
10" @ 348' Her. 2552 Win. 2604  
7" @ 2553' TD 2626 20000 A  
Comp. 13,750,000 gas 420#

**COMPLETED**

County **Finney** State **Kansas**

Sec. **8** (Blk. Twp.) **23** (Sur. Rge.) **33W** Map No.

Operator **Northern Pump**

Well No. **1** Farm **Arthur Mayer**

Elev. **2903** Location **NW SE**

|  |  |  |  |  |
|--|--|--|--|--|
|  |  |  |  |  |
|  |  |  |  |  |
**150** Ft. From **N** Line **SE**

**150** Ft. From **W** Line Quarter

Ist. Report **JUL 23 1952**

Completion *See correction*

Remarks

**Ben Brack - Contr.**

Spudding Date **7-16-52**

Drlg. Data

**10" @ 348 Her. 2552 TD 2560**

**J. G. McGEHEE**

NA1828

Map No. \_\_\_\_\_ Sec. 8 Twp. 23 R. 33W

Well No. 1 Arthur Mayer

Northern Pump Company

Contractor

NE NE SW

SECTION PLAT

150 Ft. from N. Line

\_\_\_\_\_ Ft. from S. Line

150 Ft. from E. Line

\_\_\_\_\_ Ft. from W. Line

|  |  |  |  |
|--|--|--|--|
|  |  |  |  |
|  |  |  |  |
|  |  |  |  |
|  |  |  |  |

Finney County

Location \_\_\_\_\_

Rig up \_\_\_\_\_

Drilling and Remarks:

Reported  
NW NW SE

RECORD

Cased \_\_\_\_\_ in., \_\_\_\_\_ ft.

Sand \_\_\_\_\_

Gas \_\_\_\_\_

Oil \_\_\_\_\_

Total Depth \_\_\_\_\_

PRODUCTION

1st 24 hrs. Nat. \_\_\_\_\_

1st 24 hrs. after shot \_\_\_\_\_

Gas \_\_\_\_\_ Cu. Ft.

Dry Hole \_\_\_\_\_

Abandoned \_\_\_\_\_

Date

JUL 30 1957

19

J. G. McGEHEE

McGehee  
Joe  
Scout

