

KANSAS

Section 8 Township 23 Range 34W

Well No. #1 Fleming

Company Cities Service

NORTH

WEST

EAST

			0				

SOUTH

Sec. 8 Twp. 23 R. 34W

Well No. #1 Fleming Farm

Cities Service Company
Hugoton


100 Ft. from N. Line

 Ft. from S. Line

100 Ft. from E. Line

 Ft. from W. Line

NE SW

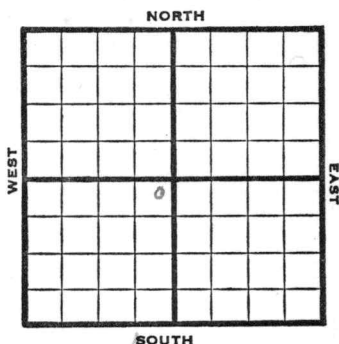

1947 Elev. 2960' REPORT

11/19 Location

11/25 "

12/3 Drlg. 680'

12/10 TD 2670'
5" @ 2679'

12/17 "

12/30 "

1948
1/7 "

1/14 TD 2681'
140 shots 2622-50'
15000 acid

1/21 120 shots 2524-48'
70 " 2488-2502'
60 " 2468-80'
50 " 2434-44
Total 31,000 Acid

1/26 "

OVER

1948

2/4

5" @ 2679'

Perf.

31,000 acid

8,770,000 Gas

429# R. Pr.

TD 2681'

Comp.

COMPLETED

Map No. _____ Sec. 8 Twp. 23 R. 34W

Well No. 1 Fleming

Cities Service

Company

FIRST REPORT

Contractor

NE SW

SECTION PLAT

	o		

100 Ft. from N. Line

_____ Ft. from S. Line

100 Ft. from E. Line

_____ Ft. from W. Line

Finney County

Location X

Rig up _____

Drilling and Remarks:

RECORD

Cased _____ in., _____ ft.

Sand _____

Gas _____

Oil _____

Total Depth _____

PRODUCTION

1st 24 hrs. Nat. _____

1st 24 hrs. after shot _____

Gas _____ Cu. Ft.

Dry Hole _____

Abandoned _____

Date

NOV 19 1947 19 _____ S. J. LEWIS Scout

No Map
Map No. _____ Sec. 8 Twp. 23 R. 34W

Well No. 1 Fleming

Cities Service

Company

COMPLETE

Contractor

NE SW

E1.2860

SECTION PLAT

	o		

100 Ft. from N. Line

_____ Ft. from S. Line

100 Ft. from E. Line

_____ Ft. from W. Line

Finney County

Location _____

Rig up _____

Drilling and Remarks:

5-102679

Ref.

31000 Acid

8,770,000 Gas

428 R/B*

RECORD

Cased _____ in., _____ ft.

Sand _____

Gas _____

Oil _____

Total Depth 2687

PRODUCTION

1st 24 hrs. Nat. _____

1st 24 hrs. after shot _____

Gas _____ Cu. Ft.

Dry Hole _____

Abandoned _____

Date

FEB 4 1948

19

S. J. LEWIS

Scout