


Section 8 Township 23 Range 36 W

Well No. # 1 Siebert Gas Unit

Company Stanolind

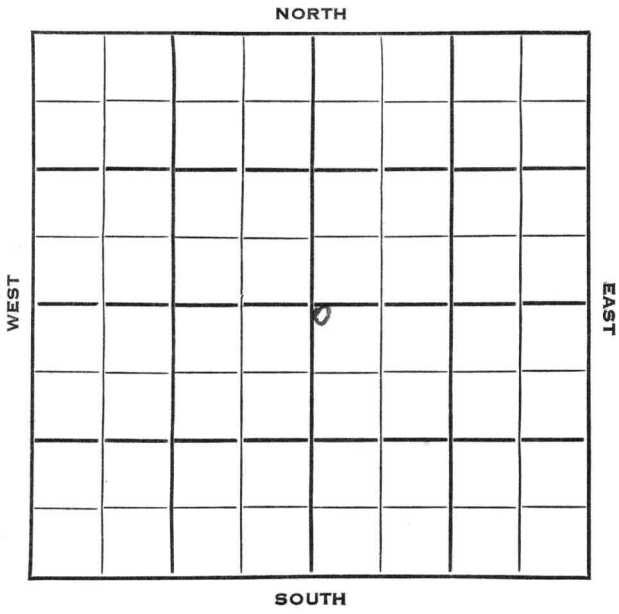

Kearny

KANSAS

SEC.	TWP.	R.
8	23	36W ✓

WELL NO. 1 Siebert Gas Unit FARM

COMPANY Stanolind

CONTRACTOR

## Hugoton Pool


150 Ft. from N. Line

Ft. from S. Line

Ft. from E. Line

150 Ft. from W. Line

NW NW SE

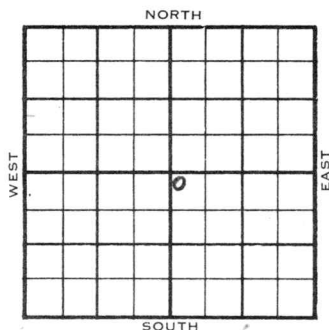

1953

ELEVATION

3159'

REPORT

10/21 Location

10/28 8" @ 720'

11/4 RTD 2715'

Schl

5" @ 2702'

Her. Kr. 2540, Win 2594, Up Ft. 2658,  
Low Ft. 2702'

11/11 CO Test.

11/24 Spud 10-24-53 Gas well TD 2715

8" @ 720 Her. 2540 Win. 2594

Ft. Riley 2658' TD 2715 5" @ 2702

CO to 2715 72/2540-52 12/2554-56

42/2560-67 66/2570-81 30/2603-08

48/2614-22 36/2646-52 90/2658-73

frac. 2658-73 2603-52 2540-81

Comp. 2,203,000 CFGPD 350#

**COMPLETED**

County **Kearny** State **Kansas**

Sec. **8** (Blk. **23**) (Sur. Rge.) **36W** Map No.

Operator **Stanolind**

Well No. **1** Farm **Siebert Gas Unit**

Elev. Location **NW NW SE**


**150** Ft. From **N** Line **SE**

**150** Ft. From **W** Line Quarter

Oct 21 1953

1st. Report

Completion

Remarks

Spudding Date

Drlg. Data **Hugoton Pool**

**Location**

FIRST REPORT

