


DX 78-1 Kearny

KANSAS

Section 8 Township 23S Range 37W

Well No. #1 Steen

Company Graham-Michaelis

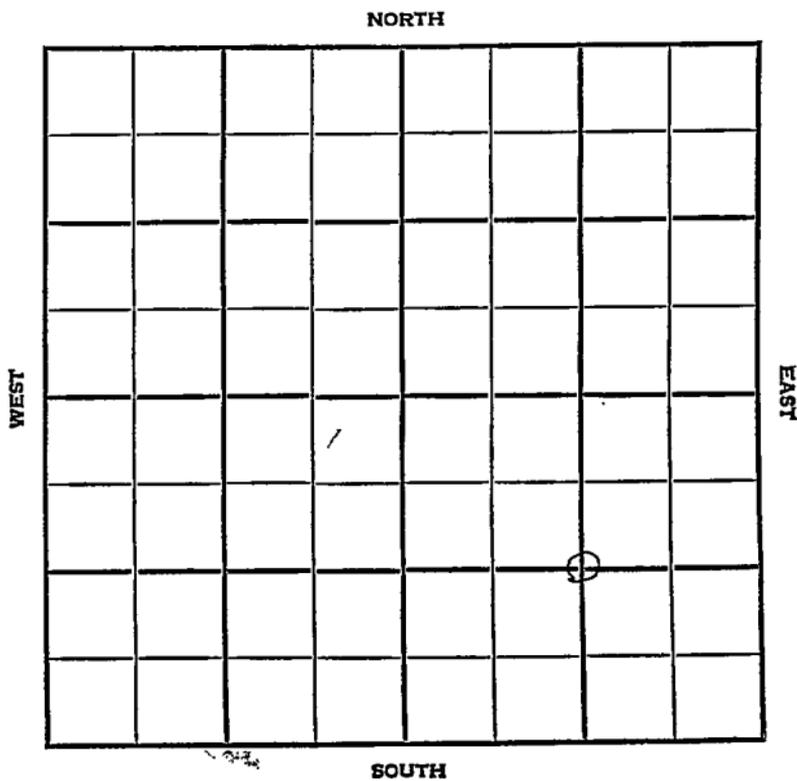


SEC. 8 - TWP. 23S R. 37W

WELL NO. #1 Steen FARM

COMPANY Graham-Michaelis

CONTRACTOR Hugoton

_____ FT. FROM N. LINE
_____ FT. FROM S. LINE
_____ FT. FROM E. LINE
_____ FT. FROM W. LINE

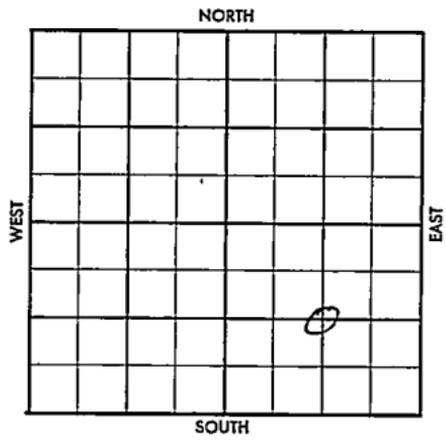

C SE/4

1956 ELEVATION REPORT

7-25 Comm. 7-20-56
7" @ 315 w/75
WOR

County Kearny Elev. _____
 Sec. 8 Twp. 23S Rge. 37W
 Company Graham-Michaelis
 Farm Name Steen No. 1

TOPS	DEPTH	LOG	DATUM	Loc. in Sec.
Anh.				C SE/4
Tp.				
H.				Geol. _____
Tr.				
Dg.				Contr. _____
Bl.				
L.				Pool _____
K.C.				
B.K.C.				Hugoton
Ce.				
C.				FIRST REPORT
M.				
M.				JUL 25 1956
K.				
Mz.				
Me.				
V.				
S.				
S.				
A.				
R.				
PE.				
G.				
T.D.				

Date Comm. 7/20/56
7" 315 w/TS WOR

3701

[Handwritten signature]

20 20

Co.
Lse.
No.
Ser.
T.
R.

County Kearny Elev. 330'
 Sec. 8 Twp. 23S Rge. 37W
 Company Graham-Michaelis
 Farm Name Steen No. 1

Co.

Loc.

No.

Sec.

T.

R.

TOPS	DEPTH	LOG	DATUM	Loc. in Sec.
Anh. <u>KR1</u>	<u>2548</u>			<u>C SE/4</u>
Tp. <u>WFH</u>	<u>2598</u>			
H. <u>UFR14</u>	<u>2658</u>			
Tr.				
Dg.				
Bl.				
L.				
K.C.				Geol.
B.K.C.				Contr.
Ce.				
C.				
M.				
M.				Pool
K.				<u>Hugoton</u>
Mz.				
Mo.				
V.				
S.				
S.				
A.				
R.				
PE.				
G.				
T.D.	<u>2660</u>			

COMPLETE
 SEP 19 '56

Date Comm. 7/20/56
7 1/2 315 W/75 WOR AUG 1 '56 WOK
AUG 8 '56 AUG 15 '56 2530 AUG 22 '56
9 1/2 2649-1300 AUG 29 '56 DD 2698
+5T 15.8 MCF @ no inc. SEP 5 '56
FRAC no inc. PB 2590 120/2550
-80 Frac channelled 50d. SEP 12 '56
RePF 2550-58 72/2602-18
FRAC CO 2698 9a 600 MCF
SEP 19 '56 complete