

KANSAS

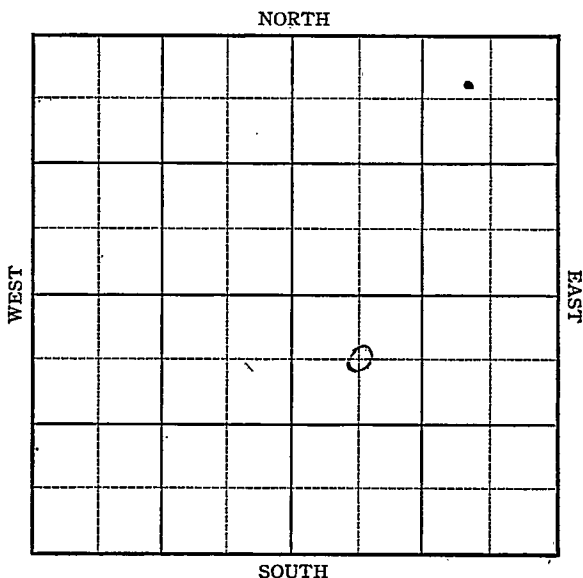
FORM 51 5M 1-42 PETROL

Harvey
h

Section 9 Township 23 Range 3 W

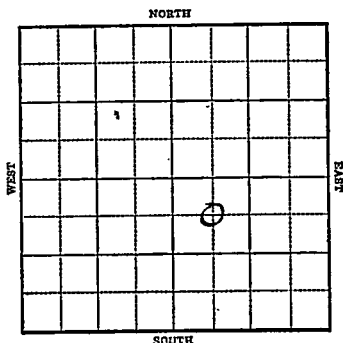
Well ~~No.~~[#] 1 Lagree

Company E.G. Holl & Branine



Harvey

KANSAS

Sec. 9 Twp. 23 R. 3-WWell No. #1 Lagree FarmE. G. Holl & Branine Company660 Ft. from N. Line Ft. from S. Line Ft. from E. Line660 Ft. from W. LineElev. 1477

1943

R E P O R T

11/17 8" @ 285'

Drlg. 1125'

11/24 Drlg. 2742'

12/1 Lans 2542

Miss 3262

TD 3315 SØ

5" @ 3305

RUST

12/8 1200' oil

12-15 " "

12/22 " "

12/29 " "

1944

1-5 3500 acid

Swb 10 oil Ph show gas.

1-12 " "

1/19 " "

1/26 " "

2/2 " "

2/8 TD 3327

Swb 10 oil per hr

2/15 TD 3385

30 shots 3277-98 SD

2/23 " "

3/1 " "

OVER

1944

3/8 PB 3342.

3/16 20 qts. 3311-19 CO

3/22 PB 3358
WOC.

3/29 "

4/5 Swb 10 oil per hr sd

4/12 " " "

4/19 " " "

4/26 " " "

5/3 5" @ 3305

Miss 3262

TD 3385

PB 3358

Flow 5 oil & 1 water Pot.

COMPLETED

Map No. 29 Sec. 9 Twp. 23 R. 3W

Well No. 1 Lagree

E. G. Holl & Branine Company

FIRST REPORT

Contractor

C NW SE

SECTION PLAT

660 Ft. from N. Line

 Ft. from S. Line

 Ft. from E. Line

660 Ft. from W. Line

		0	

Wildcat

Location

Rig up

Drilling and Remarks:

8" - 285
 1125

RECORD

Cased in., ft.

Sand

Gas

Oil

Total Depth

PRODUCTION

1st 24 hrs. Nat.

1st 24 hrs. after shot

Gas Cu. Ft.

Dry Hole

Abandoned

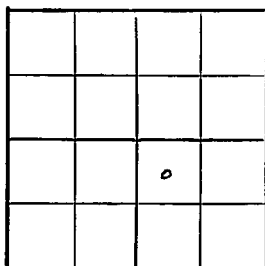
Date

NOV 1 7 1943 19 S. J. LEWIS Scout

KANSASPool Name BurrtonMap No. 39 Sec. 9 Twp. 23 R. 3WWell No. 1 LagreeE. G. Holl & Branine Company**COMPLETED**

Contractor

C NW SE

SECTION PLAT660 Ft. from N. Line Ft. from S. Line Ft. from E. Line660 Ft. from W. LineHarvey CountyLocation Rig up

Drilling and Remarks:

*Misc 3262**5' @ 3305'**PB 3358**Flow oil + 1 Water**P.S.***RECORD**Cased in., ft.Sand Gas Oil Total Depth 3385'**PRODUCTION**1st 24 hrs. Nat. 1st 24 hrs. after shot Gas Cu. Ft.Dry Hole Abandoned

Date

MAY 3 1944 19S. J. LEWIS Scout