

KANSAS

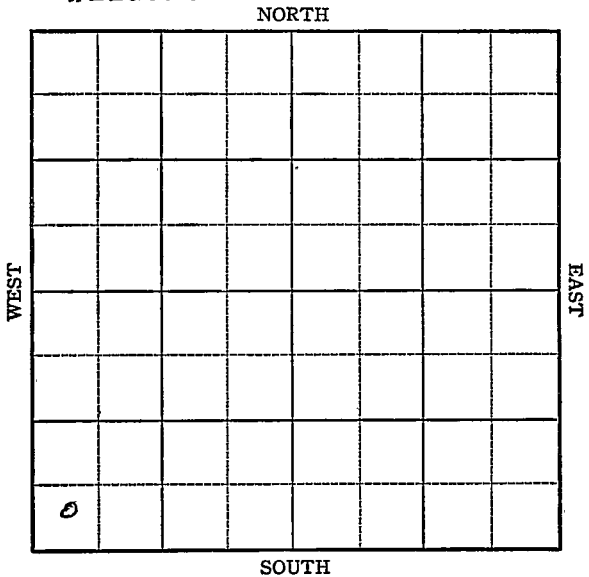
FORM 51 5M 10-41 PETROL

Reno

Section 9 Township 23 Range 9-W

Well No. #1 Wilson

Company Hollow Drilling
Wildcat

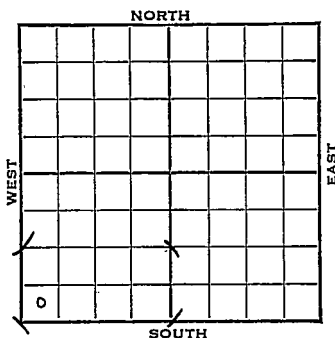


KANSAS

Reno

Sec. 9 Twp. 23 R. 9-WWell No. #1 Wilson FarmHollow Drilling Company

(Wildcat)

 Ft. from N. Line330 Ft. from S. Line Ft. from E. Line330 Ft. from W. Line

1942

REPORT

7/29

Location

8/5

8" - 241

Any 355'

Drlg. 420'

8/12

Drlg. 3152

8/19

Lans. 3254

BKC 3518

Miss. 3638

Viola 3841

Simp 3921

Arb. 3994

No shows.

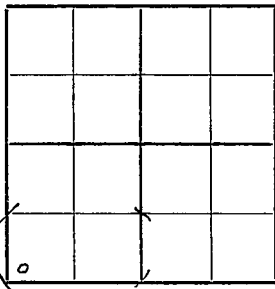
T.D. 4024'

ABANDONED

Map No. 4 / Sec. 9 Twp. 23 R. 9WWell No. 1 WilsonHollow Drilling CompanyFIRST REPORT Contractor

SW/C

SECTION PLAT

 Ft. from N. Line330 Ft. from S. Line Ft. from E. Line330 Ft. from W. Line

WILDCAT

Location XXRig up

Drilling and Remarks:

RECORD

Cased in., ft.Sand Gas Oil Total Depth

PRODUCTION

1st 24 hrs. Nat. 1st 24 hrs. after shot Gas Cu. Ft.Dry Hole Abandoned

Date

JUL 29 1942 19S. J. LEWIS Scout

Map No. 41 Sec. 9 Twp. 23 R. 9WWell No. 1 WilsonHollow Drilling

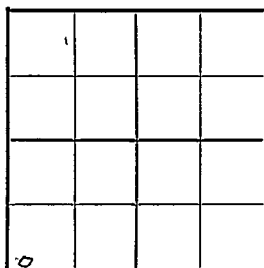
Company

ABANDONED

Contractor

SW/C

SECTION PLAT

 Ft. from N. Line330 Ft. from S. Line Ft. from E. Line330 Ft. from W. Line

WILDCAT

Location Rig up

Drilling and Remarks:

Lane 3254BKC 3518Miss 3638Vista 3841Simp 3921CLY 3994Nos 4000

RECORD

Cased in., ft.Sand Gas Oil Total Depth 4024

PRODUCTION

1st 24 hrs. Nat. 1st 24 hrs. after shot Gas Cu. Ft.Dry Hole Abandoned

Date

AUG 19 1942S. J. LEWIS Scout