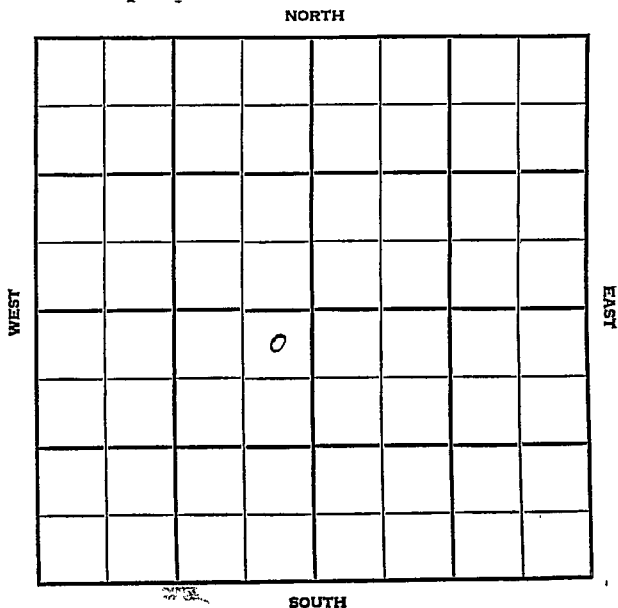


Section 9 Township 23 Range 11 WWell No. #1 HildebrandCompany J. F. Darby

Stafford

KANSAS

SEC. 9	TWP. 23	R. 11W
-----------	------------	-----------

WELL NO.

#1 Hilgebrand

FARM

COMPANY

J. F. Darby

CONTRACTOR

Iron Drlg.

Wildcat


_____ Ft. from N. Line

_____ Ft. from S. Line

_____ Ft. from E. Line

_____ Ft. from W. Line

NE NE SW

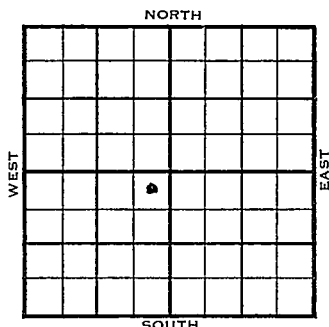

Texas Support

1955	ELEVATION 1814'	REPORT FIRST REPORT
------	--------------------	------------------------

8/10

Comm: 8-8-55

8 5/8" @277/200 WOC

8-24

DST 3626-46, open 36, min, Rec. 6' mud
0/20", TD 3790 D & A

Anh. 530, H. 3130, 3128, 1314, Tr. 3150,

1336, Dg. 3163, 1349, B.L. 3270, 3268,

1454, .. 3299, 3298, 1484, B.K.C. 3538

C. 3615, 1801, V. 3626, 3632, 1818,

S. 3679, 1865, A 3738, 3742, 1928, T.D. 3790

ABANDONED

County Stafford Elev. _____
 Sec. 9 Twp. (23) Rge. 11W
 Company J. H. Darby
 Farm Name Hildebrand No. 1

TOPS	DEPTH	LOG	DATUM	Loc. in Sec.
Anh.				NE NE SW
TP.				
H.				
Tr.				
Dg.				
BL.				
L.				Geol. _____
K.C.				Contr. _____
B.K.C.				Iron Drlg.
Ce.				
C.				Pool
M.				Wildcat
M.				
K.				
Mz.				
Me.				
V.				
S.				
S.				
A				
R.				
PE.				
G.				
T.D.				

FIRST REPORT
 AUG 10 '55

Date Comm. 8-8-55 Texas - support
8 5/8" @ 277/200 WOC

[Handwritten signature/initials]

County Stafford Elev. 1814
 Sec. 9 Twp. 28N Rge. 11W
 Company J. F. Darby
 Farm Name Hildebrand No. 1

TOPS	DEPTH	LOG	DATUM	Loc. in Sec.
Anh.	530			NE NE SW
Tr.				
H.	3130	3128	1314	
Tr.		3150	1336	
Dg.		3163	1349	
BL.	3270	3268	1454	
L.	3299	3298	1484	Geol.
K.C.				
B.K.C.	3538			Contr.
Ce.				
C.		3615	1801	Iron Drlg.
M.				
M.				Pool
K.				
Mz.				Wildcat
Mq.				
V.	3626	3632	1818	ABANDONED 0
S.		3679	1865	
S.				
A.	3738	3742	1928	
R.				
Pf.				
G.				
T.D.	3790			

Date Comm. 8-8-55 AUG 24 1955
8 5/8" @ 277/200 DST 3626-46 open 36
min. Rec. 6' mud 0/20" TD 3790
D & A