


Section 9 Township 23 Range 12W

Well No. #1 Dale "B"

Company Murfin Drlg.

NORTH

WEST

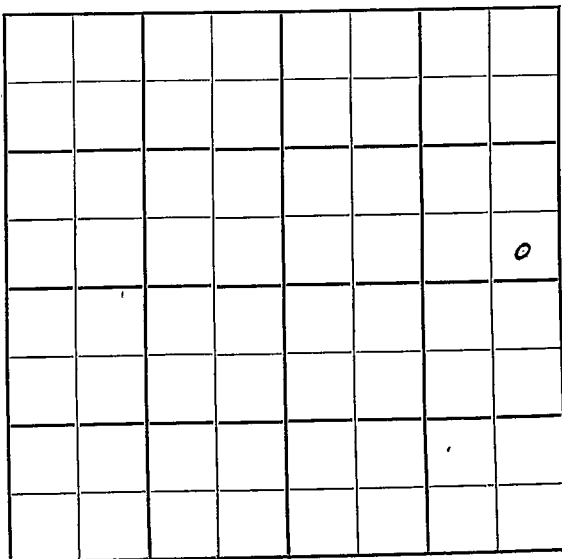

EAST

SOUTH

Stafford

KANSAS

Sec. 9 Twp. 23 R. 12 W ✓

Well No. # 1 Dale "B" Farm

Murfin Drlg. Company

Ash-Mur Contractor

Wildcat

 Ft. from N. Line


330 Ft. from S. Line

330 Ft. from E. Line

 Ft. from W. Line

SE SE NE

Stanolind DHM

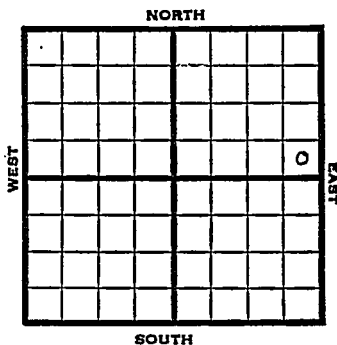

1951

Elev. 1849' REPORT

10/3

8" @ 220
Drlg. 1900'

10/17

D&A TD 3770
8" @ 220
Br. lime 3310
Lans. 3337
DST 3495-3505 open 20 min
Rec. 6' mud
Cong. 3606
Viola 3620
Simp. 3693
Arb. 3748-70 TD
D&A

ABANDONED

County **Stafford** State **Kansas**

Sec. 9 (Blk. 23) (Sur. 12W) Map No. _____

Operator **Murfin Drlg.**

Well No. **1** Farm Dale. "B"

Elev.	Location	SE	SE	NE
-------	----------	----	----	----

0

FIRST REPORT

330 Ft. From S Line NE

330 Ft. From E Line Quarter

OCT 3 1951

Ist. Report

Completion

Remarks Stanolind DEM


Ash - Mur - Contr.

Spudding Date

Drlg. Data Wildcat

8th @ 220 drlg. 1900

J. E. TYRA

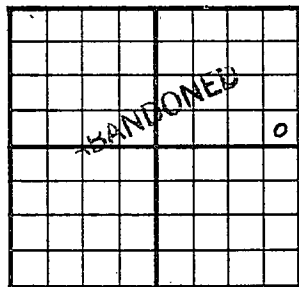County Stafford State KansasSec. 9 (Blk.
Twp.) 23 (Sur.
Rge.) 12W Map No. _____Operator Murfin Drlg.Well No. 1 Farm Dale "B"Elev. 1849 Location SE SE NE330 Ft. From S Line NE330 Ft. From E Line QuarterIst. ReportCompletion OCT 17 1951Remarks WildcatAsh-Mur - Contr.Spudding DateDrlg. Data D & A TD 37708" @ 220 Br. lime 3310 Lans. 3337DST 3495-3505 open 20 min. Rec. 6' mudCong. 3606 Viola 3620 Simp. 3693Arb. 3748-70 TDD & A

J. E. TYRA