


DX 78-1

Stafford KANSAS

Section 9 Township 23 Range 11W

Well No. 1 Batchman

Company Stearns Petr.

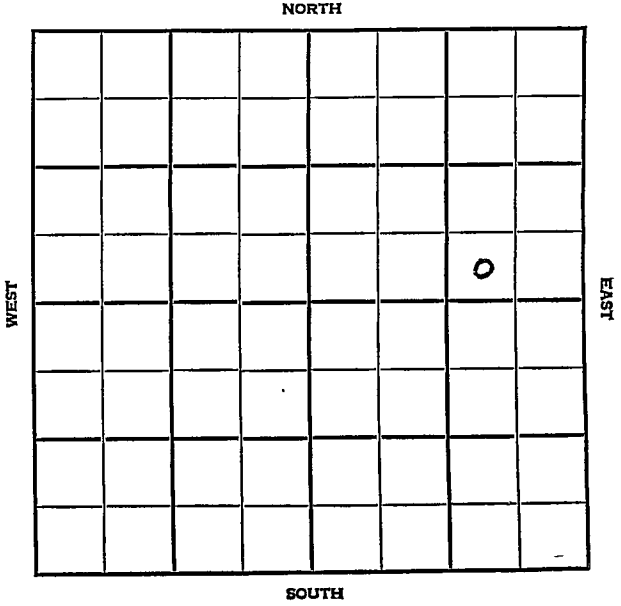

Stafford KANSAS

SEC. 9 TWP. 23 R. 14 W

WELL NO. # 1 Batchman FARM

COMPANY Stearns Pet.

CONTRACTOR Co. tools

N. Crissman Pool


_____ Ft. from N. Line

330 _____ Ft. from S. Line

990 _____ Ft. from E. Line

_____ Ft. from W. Line

SW SE NE

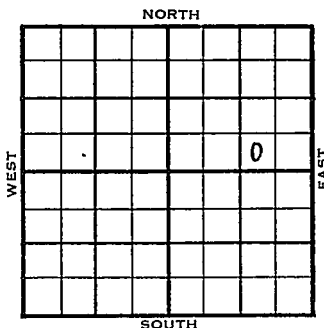

Phillips DHM

	ELEVATION	REPORT
1954	1974'	

12/22 Spud 12-20-54

1955
1/5

Spud 12-20-54 - D&A
 TD 4050'
 8" @ 423'
 Anhy 882', Heeb. 3416', Tor 3436',
 Doug. 3452', Br. lime 3546', Lans.
 3561'
 DST 3678-90', opn 1 hr., rec. 8' mud,
 0#
 DST 3741-57', opn 1 hr., rec. 10' mud,
 680#
 B KC 3791', Cong. 3880', Viola 3920'
 DST 3912-30', opn 1 hr., rec. 200'
 gas, 30' gcm, 40#
 DST 3904-30', opn 1 hr., rec. 30' mud,
 90#
 Simp. sh. 3961'
 DST 3960-92', opn 1 hr., rec. 5' mud,
 25#
 Arb. 4020'
 TD 4050'
 D&A

ABANDONED

County Stafford State Kansas

Sec. 9 (Blk. 23 (Sur. 14W (Twp. 23 (Rge. 14W Map No.

Operator Stearns Pet.

Well No. 1 Farm Hatchman

Elev. _____ Location SW SE NE

330 Ft. From S Line NE

990 Ft. From E Line Quarter

Ist. Report DEC 22 1954

Completion _____

Remarks Phillips - DHM

Co. tools

Spudding Date 12-20-54

Drlg. Data N. Crissman Pool

FABEN GILSTRAP

