


Pawnee KANSAS

SECTION 9 TOWNSHIP 23 S RANGE 15 W

WELL NO. # 3 Smith

COMPANY Stickle Drlg. Co.

S/2 NW SE NORTH

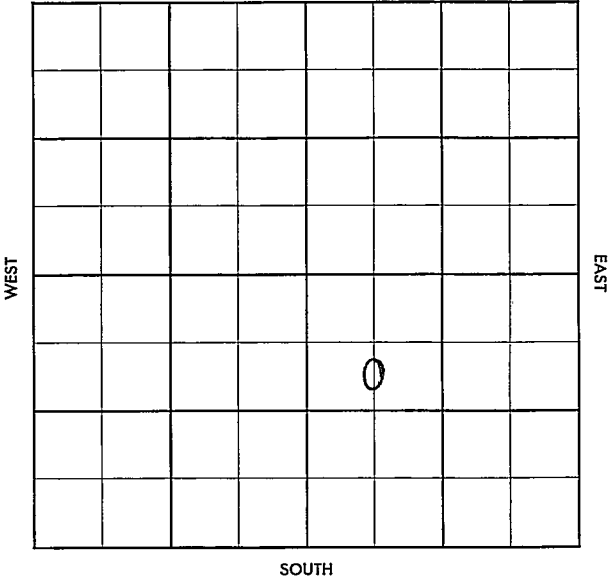

HOT FILE Pawnee KANSAS

SEC.	TWP.	R.
9	23 S	15 W

WELL NO.

3 J. T. Smith

FARM

COMPANY

Stickle Drlg. (DEVELOPMENT-OBOC)

CONTRACTOR

Co. tools

So. Jay Field.

990

FT. FROM N. LINE


FT. FROM S. LINE

FT. FROM E. LINE

660

FT. FROM W. LINE

of SE/4

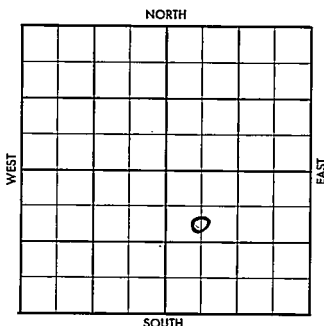S/2 NW SE
SDX-1/2 Int.

ELEVATION

1957

2022' DF

REPORT

4150' Simpson Test

8/26

Spudded 8-24-57 8" @ 409' (FR Tkt)
Drlg. 1330' (DR#166)

8/27

Drlg. 2150'

8/28

Drlg. 2385'

8/29

Drlg. 2860'

8/30

Drlg. 3315'

9/3

Drlg. 4067'

9/4

Drlg. 4155'

9/5

TD 4170'. Will complete as shallow disposal well.

9/6

TD 4170' NR

9/9

TD 4170' NR

9/10

TD 4170' NR

9/11

TD 4170' NR

(DR#177)

~~9/12 XXXXXXXXXXXXXXXX~~

9/12

~~XXXXXX~~ Spud 8-25-57
8" @ 409

DST 3997-4024, 1 hr rec 135' SWCM & SSO. BHP 1320#.

DST 4092-4120', 1 hr, 20' mud spk oil
TD 4179' D & A

H. 3497', BL 3627', L. 3638', C. 3983

C. Sd 4005', S. Sd 4101-16', Arb. 4162

TD 4179'. D & A (Scout Comp. Tkt)

ABANDONED

~~1957~~

~~9/13 TD 4170' NR (DR#179)~~

~~9/16 " " (DR#180)~~

9/20 TD 4170'. Temp. Abd. (DR#184)

ABANDONED

FORM 513 SUNRAY

Elev.

Sec. 9

Imp.



Res

754

Company Stickle-Flag Co.

Farm Name Smith

No. 2

TOPS	DEPTH	LOG	DATUM
------	-------	-----	-------

Loc. in Sec.

Anh.				S/2 NW SE
Tp.				

Tp.				3/2 Not Set
-----	--	--	--	-------------

H.			
----	--	--	--

Tr.				
-----	--	--	--	--

Dg.			
-----	--	--	--

Bi.				
-----	--	--	--	--

--	--	--	--

K.C.				Geol.
------	--	--	--	-------

R.K.C.			
--------	--	--	--

Contr.			
--------	--	--	--

Co	Tools
----	-------

00. 100.12				
------------	--	--	--	--

101.				
M				

IN.				Pool
K				

N.					Total
M.					

MZ				Page 50.
Mo				

[illegible]

V.					FIRST	Feb
----	--	--	--	--	-------	-----

S.					RECU
----	--	--	--	--	------

[illegible][illegible][illegible]

P.E.			
------	--	--	--

G.	
----	--	--	

[illegible]

T.D.						11348	20
------	--	--	--	--	--	-------	----

Date Comm. 8-25-57

8th @ 409, Dr. 2150

SD x $\frac{1}{2}$ int.

FIRST REPORT		No.

