


Section 9 Township 23S Range 15W
Well No. #1 Smith "A"
Company Stickle Drlg. Co.

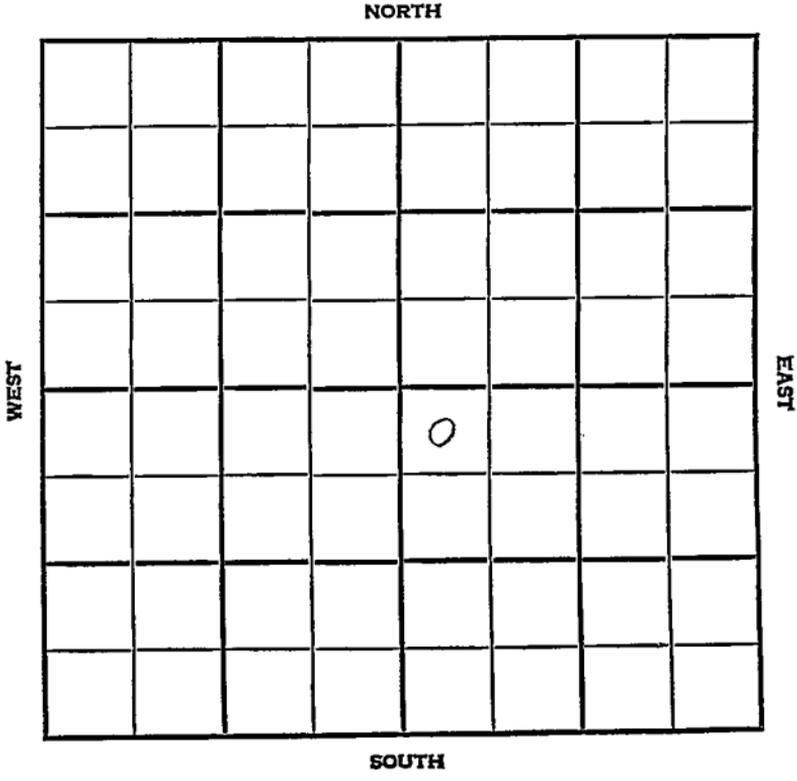


SEC. 9	TWP. 23	R. 15W
-----------	------------	-----------

WELL NO. #1 Smith ~~###~~ "A" FARM

COMPANY Stickle Drlg. Co.

CONTRACTOR Jay So. *Field*

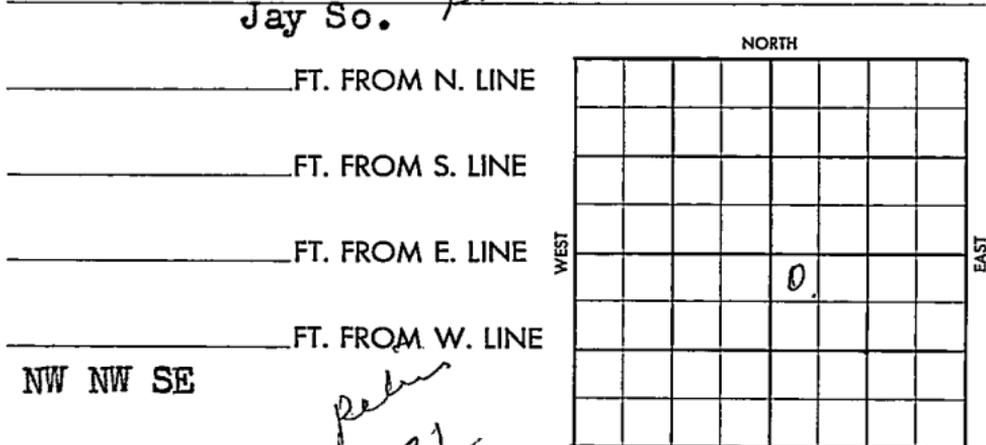

SDX - FO *221*

1956	ELEVATION 2022	REPORT (TWH6-F013)
------	-------------------	--------------------

- 6-13 Domm. 6-7-56
- 6-21 Heeb 3487, Br 1s 3609, Lsg 3616, DST 3694-3720 open 1 hr., rec 30' Vhocm, + 390' sw, 1220#; FP 80-250# DST 3784-3801 open 1 hr, 690' gas, rec 120' Vho & GCM, BHP 1220# 30" Ø 4079
- 6-28 Simp sh 4067, Simp Sd 4091, Arb 4146, TD 4161
5 1/2" @ 4141/125, Co, 25/4084-88
2 to 3 goph 250 A, frac 15 bfph, 38/4088-94, POP
- 7-5 FU 3100' oil, S/15 boph POP
- 7-11 Pot. P/ 103 BOPD / 6 of 1% ~~wt.~~ wtr.
Sp Pf. 4084-94
Log tops:
H. 3485'; BL. 3609'; L. 3618';
C. 3859'; V. 4002'; S.Sh. 4067';
S. Sd. 4077-4100, A. 4145'#
TD 4161'

COMPLETED

County Parnee Elev. _____
 Sec. 9 Twp. 29S Rgs. 15W
 Company Stickle Drlg. Co.
 Farm Name Smith Hall No. 1

TOPS	DEPTH	LOG	DATUM	Loc. in Sec.
Anh.				NW NW SE
Tp.				
H.				
Tr.				
Dg.				
Bl.				
L.				Geol. _____
K.C.				Contr. _____
B.K.C.				
Ce.				
C.				
M.				Pool _____
M.				
K.				
Mz.				Jay So. _____
Mo.				
V.				
S.				
S.				
A.				
R.				
PC.				
G.				
T.D.				

SPX - 70
 FIRST REPORT
 JUN 3 '56

Date Comm. 6/7/56

[Handwritten signature]

2201 S. 1306

Co.
Lse.
No.
Sec.
T.
R.

CORRECTION

FORM 513 SUNRAY

County Pauline

Elev. 2022

Sec. 9

Twp. 35

Rgs. 15W

Company _____

St. Louis Co.

Block B "A"

No. 1

DEPTH	LOG	DATUM
975		
3487	3485	
3609	3609	
3616	3618	
3865	3859	
4000	4002	
4067	4067	
4091	4077-4100	
4146	4145	
4161		

Loc. in Sec. _____

NW NW SW

Geol. _____

Contr. _____

Pool _____

Jay So.

70		
COMPLETE		
	0	
JUL 11	1956	

Date Comm. 6/7/56 JUN

8 5/8 288/300

Arby 975 Hb 3487 BL 3609 L59

3616 DST 3694-3720 1hr. rae. 30'

VHOCM + 390' SW 1220/30" FP

80-250# DST 3784-3801 1hr.

690' gas rae. 120' VHO & GCM BHT

1220/30" ID 4079 JUN 27 '56 sp sb.

4067 sp sd 4091 Arh 4146 RTD 4161

Ran Log 5 1/2 @ 4141/125 co

25/4084 - 88" + 1st 2 To 3 goph

FORM 513-1 SUNRAY 9-23-15W

NWNWSE

no time #149 Frac 3x3 (Acid Frac)
 tst 15 Bfph (5% Acid wt.)
 no time 38/4088-94 no tst POP.
 JUL 3 '56 FU 3100' oil ? wtu
 15 Boph ? wtu POP.
 (Chop Tops) JUL 11 '56 Xst Pat. P.
 103 Bopd + .6 of 1% wtu
 SP PF. 4084-94
 RFD 4161