



Pawnee

KANSAS

SEC.	TWP.	R.
9	23	17 W

WELL NO. # 3 Hutchinson "B" FARM

COMPANY Colorado Oil & Gas et al

CONTRACTOR Welch & Olsson

Garfield Pool


\_\_\_\_\_ Ft. from N. Line

330 \_\_\_\_\_ Ft. from S. Line

330 \_\_\_\_\_ Ft. from E. Line

\_\_\_\_\_ Ft. from W. Line

SE SE SW

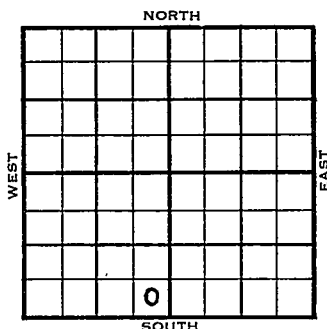

	ELEVATION	REPORT
1955	2100'	
1/12	Location	
3/9	<p>           pud 1-24-55 - Oil Well            TD 4400'            8" @ 265'            Heeb. 3680', Br lime 3789', Lans 3796'            Cong. 4220', Ch Cong 4240'            DST 4241-47', opn 1 hr., rec. 110' mud            &amp; gcm, 120' clean oil, 1250#            DST 4251-71', opn 1 hr., rec. 120'            g&amp; mco, 720' clea oil, 1250#            DST 4274-95', opn 1 hr., rec. 120' mw            0#            Viola 4369'            TD 4400'            5" @ 4399'            CO to 4370' 30/4262-68            B/3 gwph 3 hs., 250 M-A            S/6 1/2 boph 2 hrs., frac.            F/148 bo 3 hrs.            Log Tops: Heeb. 3678', Br lime 3780',            Lans. 3794', Cong 4222', Ch Cong 4237',            Misener 4302', Viola 4375'            Comp. F/614 bopd         </p>	

COMPLETED



