


Pawnee

KANSAS

SECTION 9 TOWNSHIP 23 RANGE 17 W

WELL NO. #11 Hutchinson "D"

COMPANY Colorado O & G

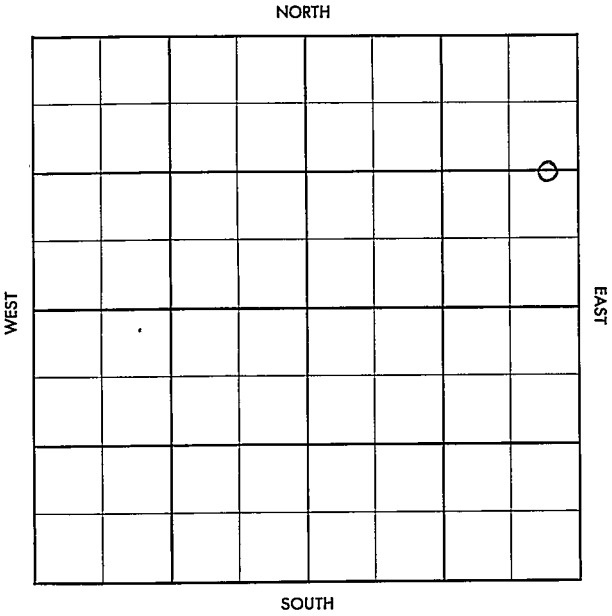

Pawnee

KANSAS


SEC.	TWP.	R.
9	23	17 W

WELL NO. #11 Hutchinson "D" FARM

COMPANY Colorado O&G

CONTRACTOR Honaker

_____ Ft. from N. Line
 _____ Ft. from S. Line
 _____ Ft. from E. Line
 _____ Ft. from W. Line

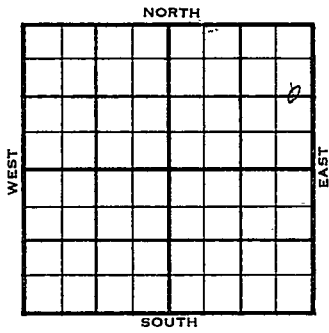

C E $\frac{1}{2}$ E $\frac{1}{2}$ NE

1955	ELEVATION	REPORT
------	-----------	--------

12-21	Comm. 12-18-55 8" @ 247/175 WOC	
-------	---------------------------------------	--

County Pawnee Elev. _____
 Sec. 9 Twp. 23 Rge. 17W
 Company Colorado O & G
 Farm Name Hutchinson "D" No. 11

Co.
Lse.
T. No.
Sec.
T.
R.

TOPS DEPTH LOG DATUM

Anh.			
TP.			
H.			
Tr.			
Dg.			
Bl.			
L.			
K.C.			
B.K.C.			
Ce.			
C.			
M.			
M.			
K.			
Mz.			
Me.			
V.			
S.			
S.			
A			
R.			
PC.			
G.			
TD.			


Loc. in Sec. C E $\frac{1}{2}$ E $\frac{1}{2}$ NE

Geol. _____
 Contr. Honaker

Pool Garfield

DEC 21 1955
 FIRST REPORT

Date Comm. 12-18-55
8" @ 247/175 WOG

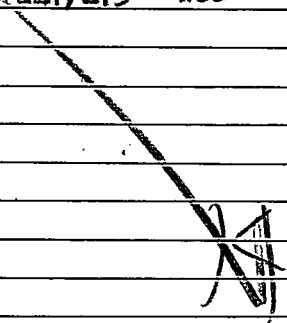


 Sec. 9 Twp. 23 Rgn. 17W
 Company Colorado O & G
 Farm Name Hutchinson "D" No. 11

TOPS	DEPTH	LOG	DATUM
Ank			
Tr.			
H.		3655	
Tr.			
Dp.			
BI			
L.	3774	3772	1674
KC			
BKC			
Co.			
C. <u>3614</u>	<u>4186</u>	<u>4182</u>	<u>2084</u>
M. <u>Co 267</u>	<u>4213</u>	<u>4212</u>	<u>2114</u>
M.			
K.			
Me.			
Mo.			
V.			
S.			
S.			
A.			
R.			
PE			
e.			
TS	<u>4325</u>		

Loc. in Sec. C E $\frac{1}{2}$ E $\frac{1}{2}$ NE

Geol. _____
 Contr. _____
Honaker

Pool _____
Garfield

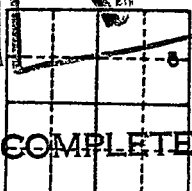

COMPLETE

Date Comm. 12-18-55 FEB 15 1956

8" @ 247/175 WOC REC 20 35 ϕ 3735

JAN 5 '56 5 $\frac{1}{2}$ " 4324 MICT CO JAN 11 '56

CO 4293 24/4266-70 tst

1 GM 1hr 42/4255-62 no show

Net ϕ .84 30 no water 2 hrs

CO 4293 ϕ 90 130 no time

12/4242-44 24/4246-50 \wedge

Frac / PB 4237 12/4232

-434 (506) + 10 Goph 36/4213

19 \$ 1.67 Boph + (556) A
Erag. Pop. JAN 18 '56 ✓ JAN 25 '56 P. Ar.
3.3 Boph 3 hrs Pop FEB 1 '56
Wopot FEB 8 '56 ✓ FEB 15 '56 Ph/P. 77
Boph/mo/w grass 38°

R.G.

FEB 27 1956