


KANSAS

DX 78-1 Pawnee

Section 9 Township 23 Range 17W

Well No. #5 Hutchinson "E"

Company Colorado O & G

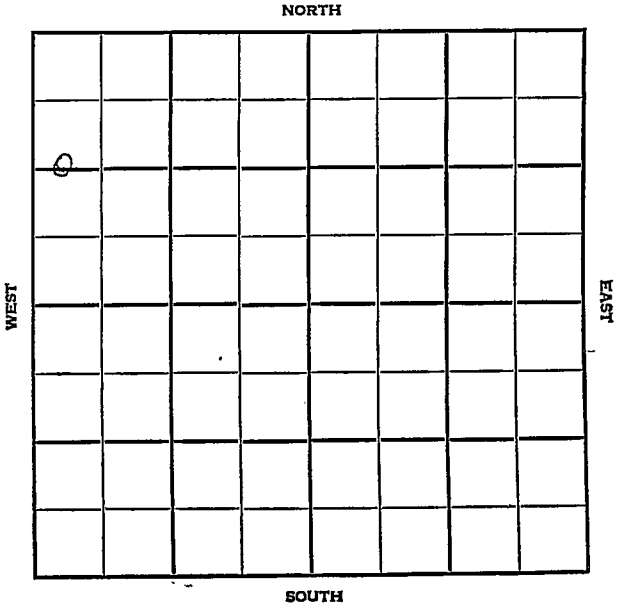

Pawnee

KANSAS

SEC. 9	TWP. 23	R. 17W
-----------	------------	-----------

WELL NO.

#5 Hutchinson "E"

FARM

COMPANY

Colorado O&G

CONTRACTOR

Honaker


Garfield

_____ Ft. from N. Line

_____ Ft. from S. Line

_____ Ft. from E. Line

_____ Ft. from W. Line

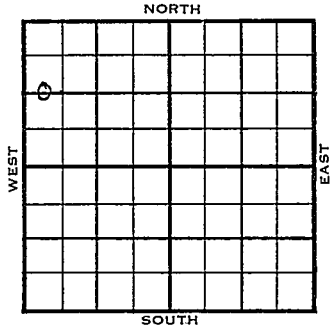C $W\frac{1}{2}$ $W\frac{1}{2}$ NW

1956	ELEVATION 2077'	REPORT
------	--------------------	--------

3-21 Comm. 3-17-56
8" @ 243/175
Drlg. 2285

5-16 $5\frac{1}{2}$ " @ 4333 w/175
CO to 4300, 40/4250-60
S/ 9 gmw, 5 hrs., 500 A,
PB 4244, 40/ 4218-28, 500 A
S/ 8 boph, 4 hrs., frac
S/ 11.68 boph, 5 hrs.
Comp. 491 bopd
TD 4345'
H. 3634', BL. 3741', L. 3748',
G.Sh. 4162', Cg. Ch. 4196', V. 4318'.

COMPLETED

County Paynee Elev. _____
 Sec. 9 Twp. 23 Rge. 17W
 Company Colorado O & G
 Farm Name Hutchinson "E" No. 5

Co.

TOPS	DEPTH	LOG	DATUM
Anh.			
Tr.			
H.			
Tr.			
Dg.			
Bl.			
L.			
K.C.			
B.K.C.			
Ce.			
C.			
M.			
M.			
K.			
Mz.			
Mq.			
V.			
S.			
S.			
A.			
R.			
Pe.			
G.			
T.D.			

Loc. in Sec. C $\frac{1}{2}$ $\frac{1}{2}$ NW

Geol. _____
 Contr. Honaker

Pool Garfield

FIRST REPORT

MAR 21 '56

1 se.


No.

Sec.

T.

R.

Date Comm. 3-17-56
8" @ 243/175 drlg. 2285

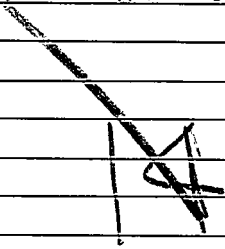

County Pawnee Elev. 2077
 Sec. 23 Twp. 17W
 Company Colorado O & G
 Farm Name Hutchinson "E" No. 5

TOPS	DEPTH	LOG	DATUM	Loc. in Sec.
Anh.				C W $\frac{1}{2}$ W $\frac{1}{2}$ NW
Tr.				
H.	<u>36.34</u>			
Dg.				
Bl.	<u>3741</u>			
L.	<u>3748</u>		<u>16.71</u>	
K.C.				Geol.
B.K.C.				Contr.
Ce.				
C.	<u>sh</u> <u>4162</u>		<u>2085</u>	Honaker
M.	<u>lg. ch.</u> <u>4196</u>		<u>2119</u>	Pool
K.				
Mz.				Garfield
Mq.				
V.	<u>4318</u>		<u>2241</u>	
S.				
S.				
A.				
R.				
PE.				COMPLETE
G.				
T.D.	<u>4345</u>			

Date Comm. 3-17-56 MAY 16 1956

8" @ 243/175 5 $\frac{1}{2}$ " @ 4333/175
CO to 4300 40/ 4250-60 S/ 9 gmw
5 hr. 500 A PB 4244 40/ 4218-28
500 A S/ 8 boph 4 hr. frac
S/ 11.68 boph 5 hr. Comp. 491 bopd