


Section 9 Township 23 Range 17 W

Well No. #1 Hutchinson "E"

Company Honaker Drlg. et al

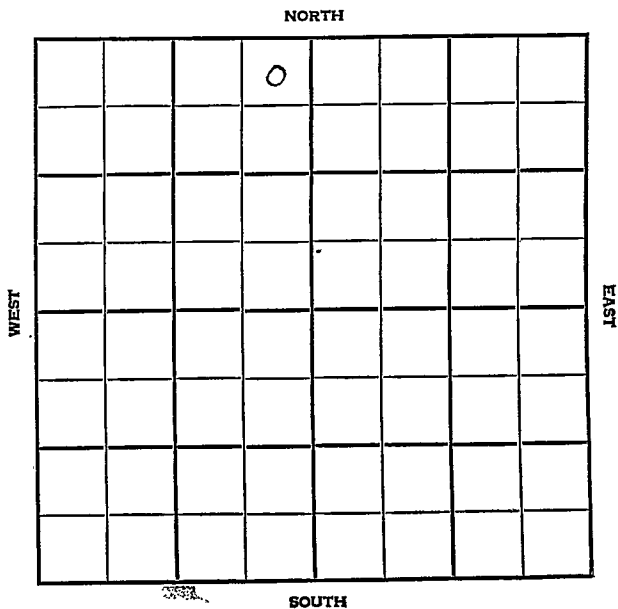

3

Pawnee

KANSAS

SEC.	TWP.	R.
9	- 23	17W

WELL NO.

#4 Hutchinson "E"

FARM

COMPANY

Honaker Drlg. et al

CONTRACTOR

Co. tools

Garfield


_____ Ft. from N. Line

_____ Ft. from S. Line

_____ Ft. from E. Line

_____ Ft. from W. Line

NE NE NW

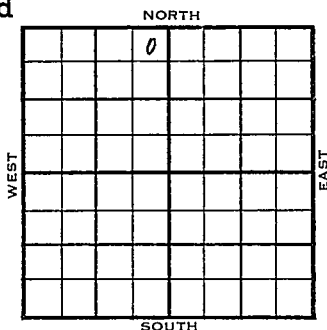

	ELEVATION	REPORT
1955	2080'	
9-14	Comm. 9-11-55 8" @ 245/175 WOC	
10/19	Comm 9-11-55 8" @ 245/175 5 1/2" @ 4376 w/175 H 3645 BL 3752 L 3760 shly 4184 Cong ch 4203 V 4369 TD 4377 Go to 4362 55/4242-57 500 A S/1 bopx frac S/60 bo 2 hr Comp BHP 3000 bopd	

COMPLETED

 Sec. 9 Twp. 23 Rge. 17W
 Company Honaker Drig. et al.
 Farm Name Hutchinson "E" No. 1

TOPS	DEPTH	LOG.	DATUM	Loc. in Sec.
Anh.				NE NE NW
TP.				
H.				
Tr.				
Dg.				
Bl.				
L.				Geol. _____
K.C.				Contr. _____
B.K.C.				Co. tools _____
Ce.				Pool _____
C.				Garfield _____
M.				
M.				
K.				
Mz.				
Mq.				
V.				
S.				
S.				
A.				
R.				
PE.				
G.				
T.D.				

	D	
SEP 14 '55		
FIRST REPORT		

Date Comm. 9-11-55
8" @ 25/175 WOC

14

County Pawnee Elev. 2080
 Sec. 9 Twp. 23 Rge. 17W
 Company Honaker Drlg. et al.
 Farm Name Hutchinson "E" No. 4

TOPS	DEPTH	LOG	DATUM	Loc. in Sec.
Anh.				NE NE NW
Tr.				
Dg.				
BL.				
L.				
K.C.				Geol.
B.K.C.				Contr.
Ce.				Co. tools
C. <u>shale</u>		<u>4184</u>	<u>2104</u>	
M. <u>Comp. sh</u>		<u>4203</u>	<u>2125</u>	
M.				Pool
K.				<u>Garfield</u>
Mz.				
Mq.				
V.				
S.				
S.				
A.				
R.				
Pe.				
G.				
TD.	<u>4377</u>			

Date Comm. 9-11-55 OCT 19 1955

8" @ 245/175 5 1/2" @ 4376/175

CO to 4362 55/ 4242-57 500 A

S/ 1 boph frac S/ 60 bo 2 hr.

Comp. BHB 3000 bopd

COMPLETE