


Pawnee

KANSAS

SECTION 9 TOWNSHIP 23 RANGE 17W

WELL NO. #6 Hutchinson "E"

COMPANY Colorado O&G

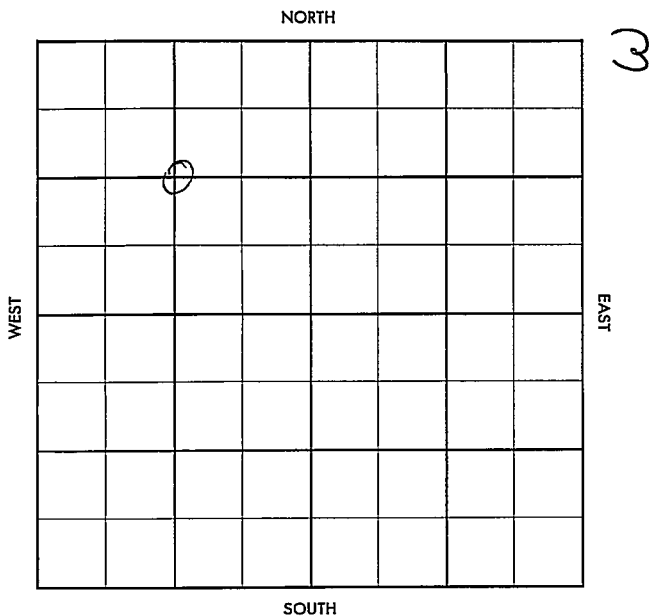

Pawnee

KANSAS

SEC. 9	TWP. 23	R. 17W
-----------	------------	-----------

WELL NO.

#6 Hutchinson "E"

FARM

COMPANY

Colorado O & G

CONTRACTOR

Honaker

Garfield


_____ Ft. from N. Line

_____ Ft. from S. Line

_____ Ft. from E. Line

_____ Ft. from W. Line

C NW/4

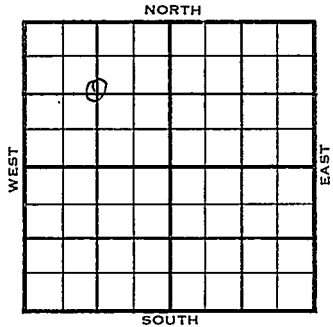

1956

ELEVATION
2093'

REPORT

4-4 Comm. 3-29-56
8" @ 241 w/175

Drlg. 2910

5-16 CO 4321, 40/ 4264-74
S/ 27 GW + 20 BO in 6 hrs.
S/ 1.67 BOPH, 60% wtr.
PB 4260, 56/4236-50, Av. 40 GOPH, no/w.
S/ 4.3 boph, no/w.
Frac, S/ 11 Boph no/wtr.
PB 4230, 32/ 4216-24
S/ 1 BOPH, no/wtrs.
Av. 22 BOPH, no/wtr., 7 hrs.
Flow 26.71 BOPH, no/wtr. 8 hrs.
CO 4260'
BH Bomb Flw. 1395 BOPD, no/wtr.
Grav. 38.
TD 4360'
BL. 3767', L. 3776', C. Sh. 4193',
Cg. Cht. 4214', V. 4342',



COMPLETED

County Pardee Elev. _____
 Sec. 9 Twp. 23 Rge. 17W
 Company Colorado O & G
 FarmName Hutchinson #1 No. 6

TOPS	DEPTH	LOG	DATUM
Anh.			
Tp.			
H.			
Tr.			
Dg.			
Bl.			
L.			
K.C.			
B.K.C.			
Ce.			
C.			
M.			
M.			
K.			
Mz.			
Mo.			
V.			
S.			
S.			
A.			
R.			
Pe.			
G.			
T.D.			

Loc. in Sec. G NW/4

Geol. _____

Contr. Honaker

(Pool) Garfield

FIRST REPORT

APR 4 '56

Date Comm. 3-29-56
8" @ 241/175 d1g. 2910

[Handwritten signature and scribbles]

Co.
Lse.
No.
Sec.
T.
R.

CORRECTION

FORM 513 SUNRAY

County Pueblo Elev. 2093
 Sec. 9 Twp. 23 Rge. 17W
 Company Colorado O & G
 Farm Name Hutchinson No. 6

TOPS	DEPTH	LOG	DATUM	Loc. in Sec.
Anh.				C NW/4
Ip.				
H.				
Tr.				
Dg.				
Bl.	3767			
L.	3776			Geol.
K.C.				Contr.
B.K.C.				Honaker
Ce.				
C.	5h 4193			Pool
M.	09 ch 4214			Garfield
M.				
K.				
Mz.				
Me.				
V.	4342			
S.				
S.				
A.				
R.				
PE.				
G.				
TD.	4360			

COMPLETE

Date Comm. 3-29-56 MAY 16 1956

8" @ 2 1/2 / 175 drlg. 2910 APR 11 56 5 1/2 @
 4356 APR 18 56 AF 5 56 CO 4321 40/
 4264-74 \$ 27.6W + 20.60 in
 6 hrs / 2 \$ 1.67 Boph 60% wtr
 PB 4260 56 / 4236-50 AV. 40
 Goph no/w 55¢. / 2 \$ 4.3
 Boph no/w frac \$ 11 Boph no/w
 PB 4230 32 / 4216-24 \$ 1 Boph
 no/w / 2 av. 22 Boph no/w 7 hrs

9 - 23 - 17W

FORM 513-1 SUNRAY

Frac Flw 26.71 Boph nolw
2 hrs POP MAY 2 '56 MAY 3 '56 MAY 15 '56 CO 4260
BH Bomb Flw 1395 Boph
nolw gran 38