


Section 9 Township 23 Range 22W

Well No. #1 Miner

Company M. B. Armer

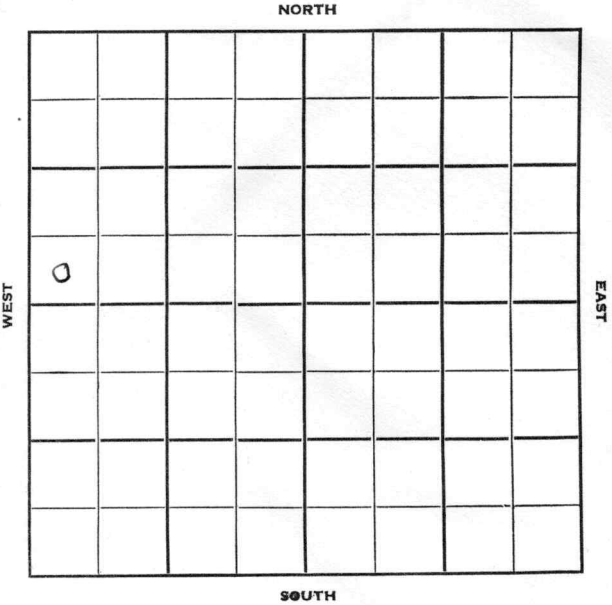

Hodgeman

KANSAS

Sec. 9 Twp. 23 R. 22W ✓

Well No. #1 Miner Farm

M. B. Armer Company

Wildcat Contractor


Ft. from N. Line

330' Ft. from S. Line

Ft. from E. Line

330' Ft. from W. Line

SW SW NW

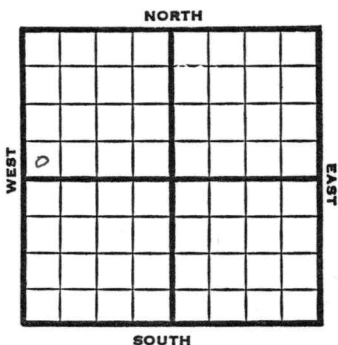

1950 Elev. 2259' REPORT

12/20 Drlg. 2075'

1951

1/10

Spud 12-14-50

D&A TD 4581

8" @ 225 Lans. 3861

Miss 4494

DST 4496-4508 opn 45 min Rec. 70'

socm TD 4581 D&A

ABANDONED

County Hodgeman State KansasSec. 9 (Blk.) 23 (Sur.) 22W Map No.Operator M. B. ArnerWell No. 1 Farm MinerElev. Location SW SW NW

0							

330 Ft. From S Line NW330 Ft. From W Line Quarter1st. Report DEC 20 1950


Completion

Remarks

Spudding Date

Drlg. Data Wildcatdrlg. 2075

J. E. TYRA

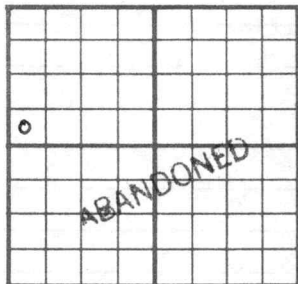County Hodgeman State KansasSec. 9 (Blk.) 23 (Sur.) 22W Map No.Operator M. B. ArmerWell No. 1 Farm MinerElev. 2259 Location SW SW NW330 Ft. From S Line NW330 Ft. From W Line Quarter

1st. Report

Completion JAN 10 1951Remarks WildcatArmer - Contr.Spudding Date 12-14-50Drilg. Data D & A TD 45818" @ 225 Lans. 3861 Miss. 4494DST 4496-4508 open 45 min. Rec. 70'socm TD 4581 D & A

J. E. TYRA