

Section 9 Township 23 Range 24WWell No. 1 SmalleyCompany I. W. Seigel

							0

NORTH

SOUTH

WEST

EAST

Hodgeman

KANSAS

SEC.	TWP.	R.
9	23	24W ✓

WELL NO.

1 Smalley

FARM

COMPANY

I. W. Seigel

CONTRACTOR

Glen Nye


Wildcat

_____ Ft. from N. Line

330 _____ Ft. from S. Line

330 _____ Ft. from E. Line

_____ Ft. from W. Line

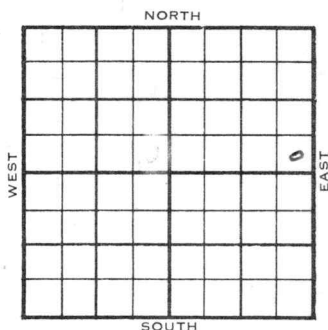

SE SE NE

Shell - DHM

1953	ELEVATION	REPORT
	2364'	
9/16		Miss Test Spud 9-10-53 8" @ 211' Drlg. 300'
9/23		SD for repairs.
9/30		Heeb 3889' Lans 3965' DST 3983-4035' 1 hr, 2695' SW 1300#
10/7		Cong 4578, Miss 4592, DST 4578'-4601' 1 hr, 450' M, 1375# DST 4602'-15, $\frac{1}{2}$ hr, 420' gas, 370' oil, 120' Hly 0 & gcm, 50' wtr, 1375# Drlg 4660'

OVER

1953
11/4

Spud 9-10-53

D&A

TD 4660'

8" @ 211'

Heeb 3889', Lans 3965'

DST 3983-4035', opn 1 hr., rec.

2695' sw, 1300#

Cong 4578', Miss 4592'

DST 4578-4601', opn 1 hr., rec.

450' mud, 1375#

DST 4602-15, opn 1/2 hrs., rec.

420' gas, 370' oil, 120' ho & gcm, 50'

wtr., 1375#

TD 4660'

5" @ 4660

CO to 4625

24/4600-06, FU 7 boph 16/4604-08,

S/4 $\frac{1}{2}$ boph 1 hr., 24/4606-12,

S/4 $\frac{1}{2}$ boph 4 $\frac{1}{2}$ hrs., 500A

S/28 bfph 75% wtr.

CO to 4613

S/10 boph dec. to 1 boph 250A

HFW & O

48/4588-4600, 52/4612-25,

CO to 4632

S/1 boph 1 $\frac{1}{2}$ bw 250A HFF

D&A


ABANDONED

County Hodgeman State Kansas
 Sec. 9 (Blk.) 23 (Sur.) 24W Map No.
 (Twp.) (Rge.)

Operator I. W. Seigel

Well No. 1 Farm Smalley

Elev. 2364 Location SE SE NE

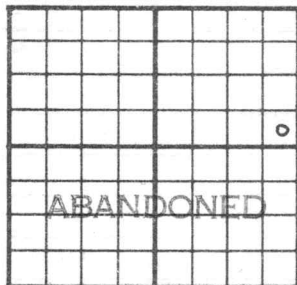

330 Ft. From S Line NE

330 Ft. From E Line Quarter

1st. Report

Completion NOV 4 1953

Remarks Wildcat

Glen Nye - Contr.

Spudding Date 9-10-53

Drlg. Data D & A TD 4660

8" @ 211 Heeb. 3889 Lans. 3965

DST 3983-4035 open 1 hr. Rec. 2695' sw

1300# Cnng. 4578 Miss. 4592 DST 4578-

4601 open 1 hr. Rec. 450' mud 1375#

DST 4602-15 open 1/2 hr. Rec. 420' gas

370' oil 120' ho & gcm 50' wtr. 1375#

TD 4660 5" @ 4660 CO to 4625

24/ 4600-06 FU 7 boph 16/ 4604-08

S/ 4 1/2 boph 1 hr. 24/ 4606-12

S/ 4 1/2 boph 4 1/2 hr. 500 A S/ 28 bfph

75% wtr. CO to 4613 S/ 10 boph

dec. to 1 boph 250 A HFW & O

48/ 4588-4600 52/ 4612-25 CO to 4632

S/ 1 boph 1 1/2 bw 250 A HFF

D & A

J. G. McGEHEE