


Section 9 Township 23 Range 24W

Well No. 1 Smalley "C"

Company M. B. Armer

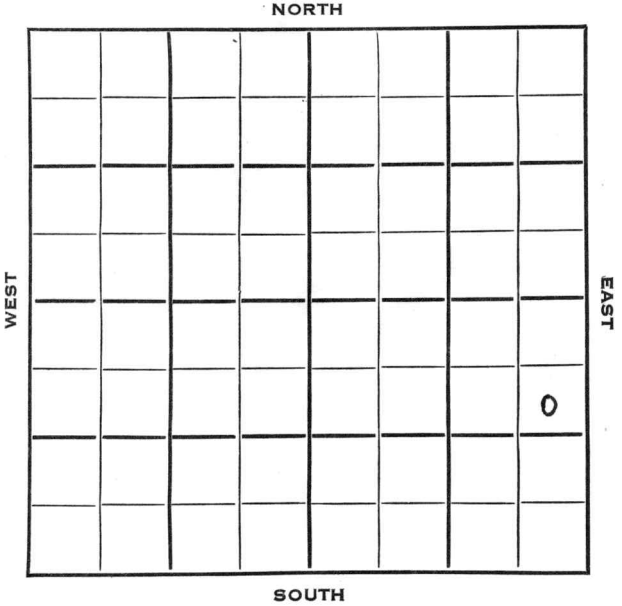

Hodgeman

SEC. 9 TWP. 23 R. KANSAS 24W ✓

WELL NO. #1 Smalley "C" FARM

COMPANY M.B. Armer

CONTRACTOR Armer


Wildcat.

990 Ft. from N. Line

Ft. from S. Line

330 Ft. from E. Line

Ft. from W. Line

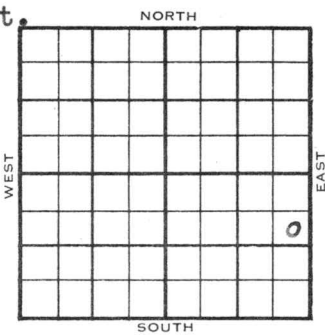

SE NE SE

1954 ELEVATION 2373' REPORT

1/6 Spud 1-4-54  
Drlg 100'

1/13 8" @ 187'  
Drlg 3800'

1/20 D & A

1/27 Spud 1-4-54  
D & A  
TD 4725'  
8" @ 187'  
Heeb 3904', Br. Lime 3951', Lans 3981'  
Cong 4599'  
TD 4725' **ABANDONED**  
D & A



County Hodgeman State Kansas

Sec. 9 (Blk. 23) (Sur. 24W) (Twp.) (Rge.) Map No.

Operator M. B. Armer

Well No. 1 Farm Smalley "C"

Elev. 2373 Location SE NE SE


990 Ft. From N Line SE

330 Ft. From E Line Quarter

1st. Report

Completion JAN 27 1954

Remarks Wildcat

Armer - Contr.

Spudding Date 1-4-54

Drlg. Data D & A TD 4725

8" @ 187 Heeb. 3904 Br. lime 3951

Lans. 3981 Cong. 4599 TD 4725

D & A

J. G. McGEHEE