

Finney


KANSAS

SECTION 9 TOWNSHIP 23 RANGE 32W

WELL NO. #1 Gas Unit Aleda Ross

COMPANY Texas Company

NORTH

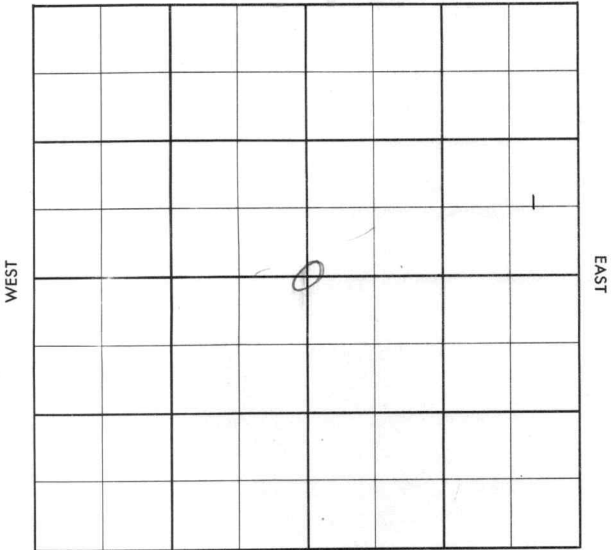

SOUTH

Finney

KANSAS

SEC.

TWP.

R.

9

23

32W

WELL NO.

#1 Gas Unit Aleda Ross

FARM

COMPANY

Texas Company

CONTRACTOR

Walter Kuhn

Hugoton


_____ FT. FROM N. LINE

_____ FT. FROM S. LINE

_____ FT. FROM E. LINE

_____ FT. FROM W. LINE

C Sec.

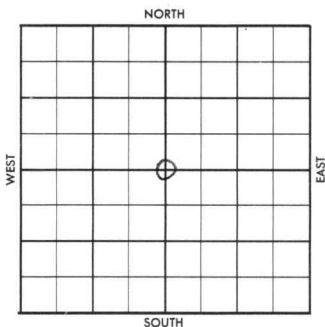

1956

ELEVATION

REPORT

9-5

Comm 8-28-56
8" @ 518 w/350
Dr1g 2515

County Finney Elev. _____
 Sec. 9 Twp. 23 Rge. 32W
 Company Texas Company
 Farm Name Gas Unit Aleda Ross No. 1

TOPS	DEPTH	LOG	DATUM
Anh.			
Tp.			
H.			
Tr.			
Dg.			
Bl.			
L.			
K.C.			
B.K.C.			
Ce.			
C.			
M.			
M.			
K.			
Mz.			
Mq.			
V.			
S.			
S.			
A.			
R.			
Pe.			
G.			
T.D.			

Loc. in Sec. _____

C Sec.

Geol. _____

Contr. _____

Walter Kuhn

Pool _____

Hugoton

SEP 5 1956

FIRST REPORT

Date Comm. 8-28-56
8" @ 518/350 drlg. 2515

35

County Finney Elev. 2781
 Sec. 9 Twp. 23 Rge. 32W
 Company Texas Company
 Farm Name Gas Unit Aleda Ross No. 1

TOPS	DEPTH	LOG	DATUM	Loc. in Sec.
Anh.				C Sec.
Tp. <u>Holl</u>		<u>2593</u>		
H. <u>Herr</u>		<u>2616</u>		
Tr. <u>Kr</u>		<u>2630</u>		
Dg. <u>WFI</u>		<u>2694</u>		
Bl.				
L.				Geol.
K.C.				Contr.
B.K.C.				<u>Walter Kuhn</u>
Ce.				Pool
C.				<u>Hugoton</u>
M.				
M.				
K.				
Mz.				
Ma.				
V.				
S.				
S.				
A.				
R.				
Pe.				
G.				
T.D.	<u>2708</u>			COMPLETE

Date Comm. 8-28-56

8" @ 518/350 drlg. 2515 SEP 12 '56 DST
 2500-25 1 hr. run 1 1/2' ID MD
 BHR 25 5 1/2 2696/800 CO 2708
 tst dry. SEP 19 '56 PB 2691 128/
 2630-62 tst Tr. 925 F12C
 +st 1,377 MCF S.I. 13 hrs +st
 974 MCF F12C +st 2,328 MCF
 (wet) S.I. SEP 26 '56 +st 2,115 MCF
 +20 Gwph OCT 3 '56 10 1/2 hr. 10,220

MCFGPD +120 GWPH

PB 2654 ga. 1.920 MCF + 600

GWPH wtr dec to 120 busph

OCT 10 '58

+st 1.665 MCF + 83 GWPH

ga 1.750 MCF + 55 GWPH ga

1.590 MCF + 37 GWPH OCT 17 '58

72-20 S. 100 MCFGPD

SIT 340