


Section 9 Township 23 Range 34WWell No. #1 BartlowCompany Champlin Ref.

NORTH

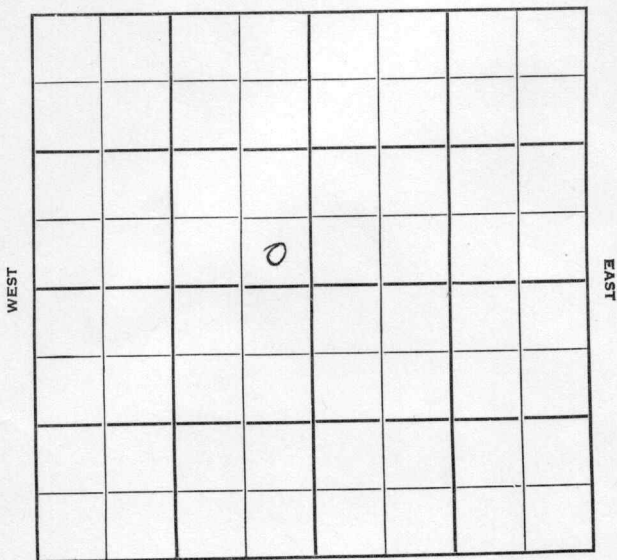

SOUTH

Sec. 9 Twp. 23 R. 34W

Well No. #1 Bartlow Farm

Champlin Ref. Company

Hugoton Pool Contractor


 Ft. from N. Line

330' Ft. from S. Line

330' Ft. from E. Line

 Ft. from W. Line

SE SE NW

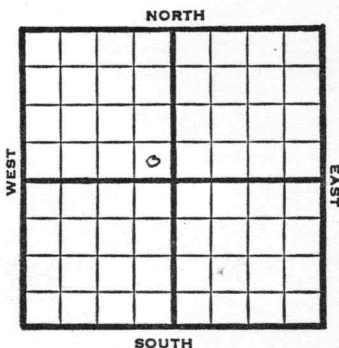

1950

Elev 2957

REPORT

6/21

Location

8/2

10 3/4" @ 610 7" @ 2630 TD 2631
Her 2432 Krider 2458
Win 2518 Ft. Riley 2576
24/2606-10 30/2589-94
42/2577-84 90/2481-96/
96/2458-74
30,000 total acid
Test 3,169,000 gas 42/2432-39
Comp. open flo w 13,341,000 388#
Completed

COMPLETED

Map No. _____ Sec. 9 Twp. 23 R. 34WWell No. 1 Bartlow

_____ Champlin Ref. _____ Company

_____ Contractor

SE SE NW

SECTION PLAT

_____ Ft. from N. Line

330 Ft. from S. Line330 Ft. from E. Line

_____ Ft. from W. Line



Finney County

Location X

Rig up _____

Drilling and Remarks:

RECORD

Cased _____ in., _____ ft.

Sand _____

Gas _____

Oil _____

Total Depth _____

PRODUCTION

1st 24 hrs. Nat. _____

1st 24 hrs. after shot _____

Gas _____ Cu. Ft.


Dry Hole _____

Abandoned _____

Date

JUN 21 1950 19J. E. TYRA Scout

County Finney State Kansas
 Sec. 9 (Blk.) 23 (Sur.) 34W Map No.
 Operator Champlin Ref.
 Well No. 1 Farm Bartlow
 Elev. 2957 Location SE SE NW

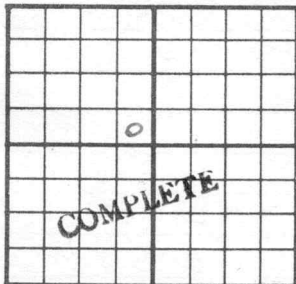

330 Ft. From S Line NW
330 Ft. From E Line Quarter

1st. Report

Completion AUG 2 1950

Remarks

Spudding Date

Drlg. Data

Hugoton Pool

10 3/4" @ 610 7" @ 2630 TD 2631

Her. 2432 Krider 2458 Win. 2518

Ft. Riley 2576 24/ 2606-10 30/ 2589-94

42/ 2577-84 90/ 2481-96 96/ 2458-74

30,000 total acid

Test. 3,169,000 gas 42/ 2432-39

Comp. open flow 13,341,000 388#

J. E. TYRA