

Kearney

KANSAS


SECTION 9 TOWNSHIP 23 RANGE 35W

WELL NO. #1 Gilmore

COMPANY Graham-Michaelis

NORTH

C SE/4

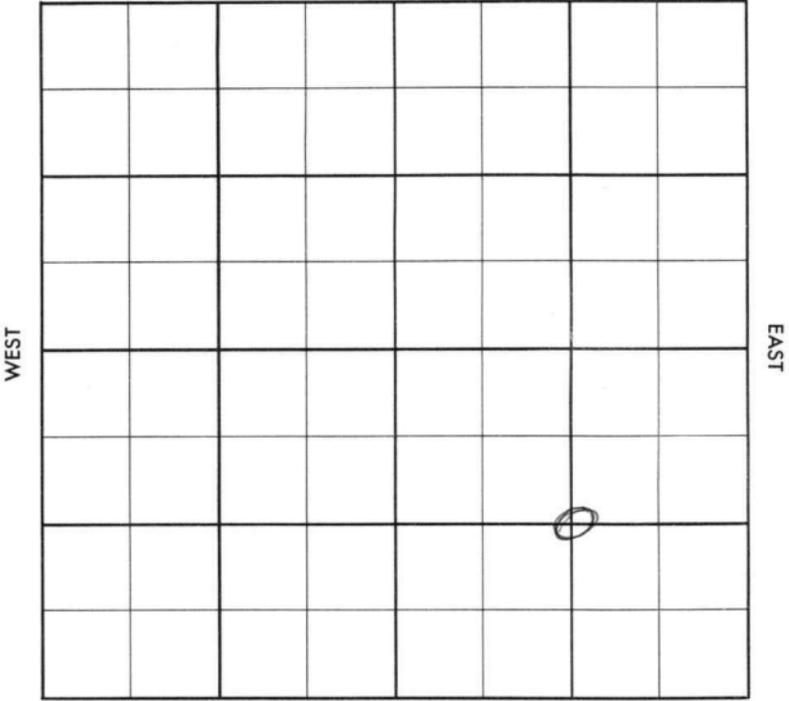

SOUTH

County Kearney Elev. 3027 DF
 Sec. 9 Twp. 23 Rge. 35W
 Company Graham-Michaelis
 Farm Name Gilmore No. 1

TOPS	DEPTH	LOG	DATUM	Loc. in Sec.
Anh.				C SE /4
Tr.				
H. <u>Herr.</u>	<u>2198</u>			
Tr. <u>Kri.</u>	<u>2530</u>			
Dg. <u>Win.</u>	<u>2387</u>			
Bl. <u>Tow.</u>	<u>2646</u>			
L.				Geol.
K.C.				Contr.
B.K.C.				Co. Tools
Ce.				Pool
C.				Hugoton
M.				<div style="border: 1px dashed black; padding: 5px; text-align: center;"> <p>FIRST REPORT</p> <p>APR 24 '57</p> </div>
M.				
K.				
Mz.				
Me.				
V.				
S.				
S.				
A.				
R.				
PE.				
G.				
T.D.	<u>2660</u>			

Date Comm. 4-18-57 Pan American - (FO)
8" @ 353/175, 5" @ 2659/300 - WOCT

34

Co. Lse. No. Sec. T. R.

County Kearney Elev. 3027 DF
 Sec. 9 Twp. 23 Rge. 35W
 Company Graham-Michaelis
 Farm Name Gilmore No. 1

Co.

TOPS	DEPTH	LOG	DATUM	Loc. in Sec.
Anh.				C SE 1/4
Tr.				
H. <u>Herr.</u>	<u>2198</u>			
Tr. <u>Kri.</u>	<u>2530</u>			
Dg. <u>Win.</u>	<u>2587</u>			
Bl. <u>Tow.</u>	<u>2646</u>			
L.				Geol.
K.C.				Contr.
B.K.C.				Co. Tools
Ce.				Pool
C.				Hugoton
M.				
M.				
K.				
Mz.				
Me.				
V.				
S.				
S.				
A.				
R.				
Pe.				
G.				
T.D.	<u>2660</u>			

Loc.

No.

Sec.

T.

R.

COMPLETE
 MAY 29 '57

Date Comm. 4-18-57 Pan American - (FO)
 8" @ 353/175, 5" @ 2659/300 - WOCT MAY 1 '57
 CO MAY 8 '57 CO 2655 12/21-43-52
 1/2" DO 925 S.P. MAY 15 '57 P/9
 @ 2605 48/2586-98 1/2" 9a
 200 MCFG FRAC 9a 1,300
 MCFG P/9 @ 2565 32/2536
 -44 24/2552-58 FRAC CO
 2655 9a 2,537 MCFG 4hr
 MAY 22 '57 MAY 29 '57 72-20 9a 8,770 MCFG
 RP 390 #