

Kearny

KANSAS

SECTION 9 TOWNSHIP 23 RANGE 37 TH

WELL NO. #1 Bell "B"

COMPANY Cities Service

NORTH

			0				

WEST

EAST

SOUTH

Kearny

KANSAS


SEC. 9	TWP. 23	R. 37W
-----------	------------	-----------

WELL NO. #1 Bell "B" FARM

COMPANY Cities Service

CONTRACTOR

225 Ft. from N. Line
 Ft. from S. Line
 200 Ft. from E. Line
 Ft. from W. Line

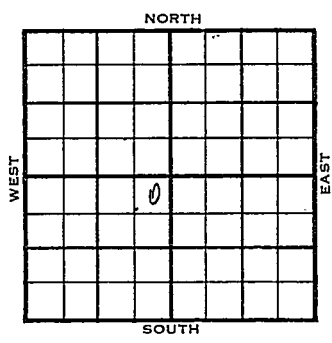

NE NE SW

	ELEVATION	REPORT
1955	3291	
12-28	Comm. 12-21-55 8 5/8" @ 140/400	
<u>1956</u>		
1-25	5 1/2" @ 2271 CO 80/ 2684-2704, 1000 A, 260 mcfg SP 2674, 40/ 2644-54, 56/ 2586-2600 44/ 2546-55, 3000 A, frac CO to 2701 Comp. 4,050 mcfgpd Winf. 2642. TD 2720	

COMPLETED

County Kearny Elev. 3291
 Sec. 9 Twp. 23 Rge. 37W
 Company Cities Service
 FarmName Bell "B" No. 1

TOPS	DEPTH	LOG	DATUM
Anb.			
Tp.			
H.			
Tr.			
Dg.			
Bl.			
L.			
K.C.			
B.K.C.			
Ce.			
C.			
M.			
M.			
K.			
Mz.			
Mq.			
V.			
S.			
S.			
A.			
R.			
PE.			
G.			
T.D.			

Loc. in Sec. NE NE SW
225' NL
200' EL
 Geol. _____
 Contr. _____
 Pool _____

FIRST REPORT
 DEC 25 '55

Date Comm. 12-21-55
8 5/8" @ 110/100

34

Co.
Lse.
No.
Sec.
T.
R.

County Kearny Elev. 3291
 Sec. 9 Twp. 23 Rge. 37W
 Company Cities Service
 FarmName Bell "B" No. 1

TOPS	DEPTH	LOG	DATUM
------	-------	-----	-------

Anh.			
Tp.			
H.			
Tr. <u>Wing</u>	<u>2642</u>		
Dg.			
Bl.			
L.			
K.C.			
B.K.C.			
Ce.			
C.			
M.			
M.			
K.			
Mz.			
Me.			
V.			
S.			
S.			
A.			
R.			
PE.			
G.			
T.D.	<u>2720</u>		

Loc. in Sec. NE NE SW
225' NL
200' EL

Geol. _____

Contr. _____

Pool _____

COMPLETE		
0		

Date Comm. 12-21-55 JAN 25 1956

8 5/8" @ 140/400 5 1/2" @ 2271 CO

80/ 2684-2704 1000 A 260 mcfg

SP 2674 40/ 2644-54 56/ 2586-2600

44/ 2546-55 3000 A frac CO to 2701

Comp. 4,050 mcfgpd

