

KANSAS


Stafford

FORM 51 5M 1-42 PETROL

Section 1 Township 24 Range 11-W

Well No. #2 Krey

Company Tatlock

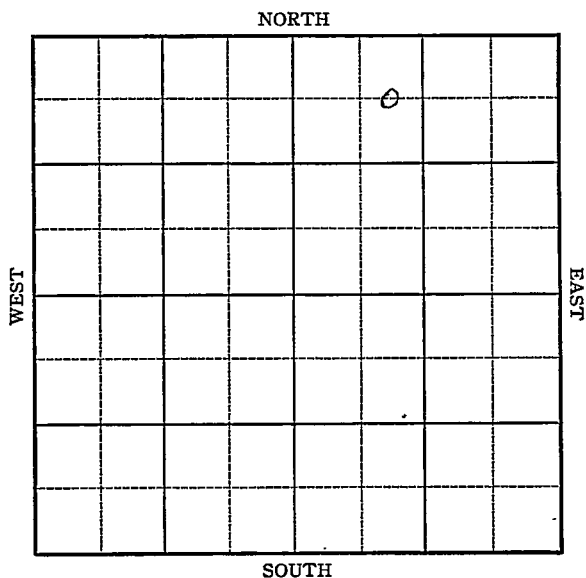

KANSAS

Stafford


Sec. 1 Twp. 24 R. 11-WWell No. #2 Krey FarmTatlock Company

Zenith

660 Ft. from N. Line

Ft. from S. Line

Ft. from E. Line

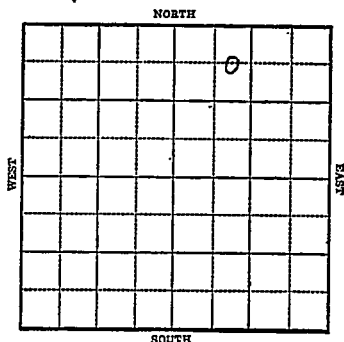990 Ft. from W. LineSec. 1810

1943

R E P O R T

4/14	Location.
4/21	"
4/28	"
5/5	"
5/12	Derrick
5/19	10" @ 315
	Drlg. 780'
5/26	Drlg. 2745
	Anhy 490'
6/2	Drlg. 3695
6/9	Misner 3690
	Viola 3704
	T.D. 3709
	7" @ 3705 Rust
6/16	T.D. 3711
	Swab $2\frac{1}{2}$ oil per hr.
6/23	200 acid flow 301 Pot.
6/30	" " " " "
7/7	- Viola 3704
	7" @ 3705
	T.D. 3711
	2000 acid
	Flow 301 Pot
	Gravity 42

COMPLETED

Stafford

Map No. KANSAS Sec. 1 Twp. 24 R. 11WWell No. 2 KreyTatlock

Company

FIRST REPORT

Contractor

C E L N W N E

SECTION PLAT

		o	

660 Ft. from N. Line

Ft. from S. Line

Ft. from E. Line

990 Ft. from W. Line

ZENITH POOL

Location XXX

Rig up

Drilling and Remarks:

RECORD

Cased _____ in., _____ ft.

Sand _____

Gas _____

Oil _____

Total Depth _____

PRODUCTION

1st 24 hrs. Nat. _____

1st 24 hrs. after shot _____

Gas _____ Cu. Ft.

Dry Hole _____

Abandoned _____

Date

APR 14 1943 19S. J. LEWIS Scout

Stafford

KANSAS 17
Map No. _____ Sec. 1 Twp. 24 R. 11W

Well No. 2 Krey

Tatlock Company

COMPLETED Contractor

C EL NW NE

660 Ft. from N. Line

Ft. from S. Line

Ft. from E. Line

990 Ft. from W. Line

SECTION PLAT

ZENITH POOL

Location _____

Rig up _____

Drilling and Remarks:

Vid la 3704

7" @ 3705.

2000 acd/c

Flow 301 Bx

42 e/c

RECORD

Cased _____ in., _____ ft.

Sand _____

Gas _____

Oil _____

Total Depth 3711

PRODUCTION

1st 24 hrs. Nat. _____

1st 24 hrs. after shot _____

Gas _____ Cu. Ft.

Dry Hole _____

Abandoned _____

Date

III 7 1943 19

S. J. LEWIS Scout