

KANSAS


FORM 51 5M 1-42 PETROL

Stafford

Section 1 Township 24 Range 11-W

Well No. #4 McNickle

Company Transwestern

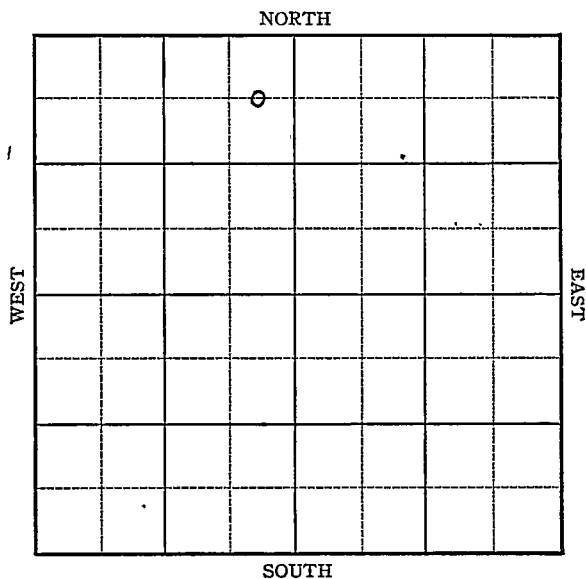

KANSA

Stafford

Sec. 1 Twp. 24 R. 11-W

Well No. #4 McNickle Farm

Transwestern Company


Zenith

660 Ft. from N. Line

 Ft. from S. Line

330 Ft. from E. Line

 Ft. from W. Line

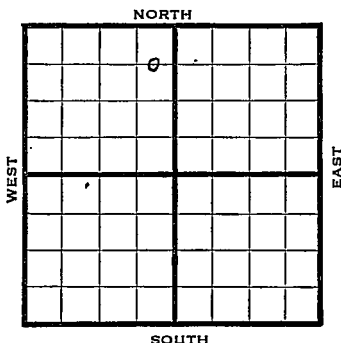

1943

Elev. 1806

REPORT

8/4 Location.

8/11 Rotary

8/18 8" @ 330'
Drlg. 1200'

8/25 2035 fsg.

9/1 " "

9/8 " "

9/15 Drlg. 3517'

9/22 Viola 3704-08 T.D.
5" @ 3706 Rust

9/29 Drlg. 3725'
No shows.

10/6 Viola 3704
5" @ 3706'
Gravity 42
T.D. 3734'

COMPLETED

Stafford

KANSASMap No. 7/7 Sec. 1 Twp. 24 R. 11WWell No. 4 McNickleTranswestern

Company

FIRST REPORT

Contractor

C EL NE NW

SECTION PLAT

	0		

660 Ft. from N. Line Ft. from S. Line330 Ft. from E. Line Ft. from W. LineZENITH POOLLocation XXXRig up

Drilling and Remarks:

RECORD

Cased in., ft.Sand Gas Oil Total Depth

PRODUCTION

1st 24 hrs. Nat. 1st 24 hrs. after shot Gas Cu. Ft.Dry Hole Abandoned

Date

AUG 4 1943 19S. J. LEWIS

Scout

KANSAS
 Map No. 47 Sec. 1 Twp. 24 R. 11W
 Well No. 4 McNickle

Transwestern Company

COMPLETED Contractor

C E L NE NW


660 Ft. from N. Line

 Ft. from S. Line

330 Ft. from E. Line

 Ft. from W. Line

SECTION PLAT

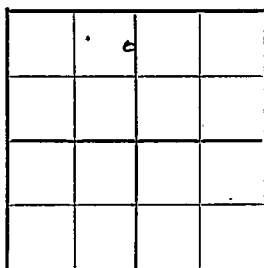

Zenith Pool

Location

Rig up

Drilling and Remarks:

Vida 3704

5" C 3706

Pump 226 Pox

42 9/16

RECORD

Cased in., ft.

Sand

Gas

Oil

Total Depth 3234

PRODUCTION

1st 24 hrs. Nat.

1st 24 hrs. after shot

Gas Cu. Ft.

Dry Hole

Abandoned

Date

OCT 6 1943 19

S. J. LEWIS Scout