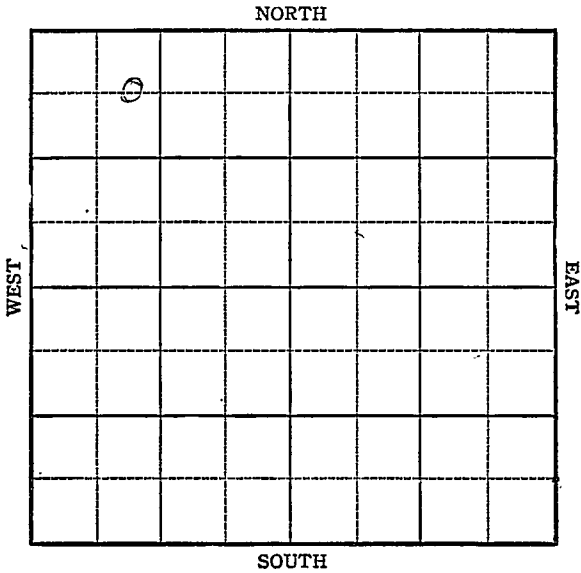


KANSAS

FORM 51 5M BRIX

Section 1 Township 24 Range 11WWell No. #5 McNickleCompany Transwestern

KANSAS

Stafford

Sec. 1 Twp. 24 R. 11W

Well No. #5 McNickle Farm

Transwestern Company


Zenith

660 Ft. from N. Line

 Ft. from S. Line

 Ft. from E. Line

990 Ft. from W. Line

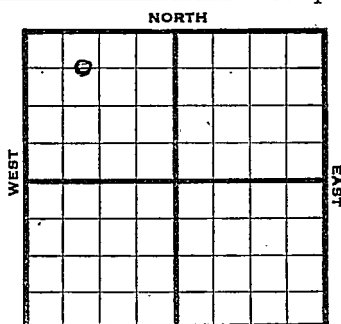

CEL NW NW Elev - 1807 SOUTH

1945

R E P O R T

2/14	R U R
2/21	8" @ 332 Drlg 2075
2/28	Drlg 3390
3/7	Lans 3330 Viola 3721 -24 TD 5" @ 3722 RUST
3/14	" " " "
3/23	" " " "
3/29	TD 3736 swb 40 oil plus 20 wtr. in 10 hrs.
4/5	" " " " " " " "
4/11	Viola 3721 5" @ 3722 TD 3736 Pump 85 oil plus 30% wtr. Pot. Grav. 42.0

COMPLETED

Pool Name ZenithMap No. K-47 Sec. 1 Twp. 24 R. 11WWell No. 5 McNickleTranswestern

Company

FIRST REPORT

Contractor

C E L NW NW

SECTION PLAT

<u>660</u>	Ft. from N. Line				
	Ft. from S. Line				
	Ft. from E. Line				
<u>990</u>	Ft. from W. Line				

Stafford

Location

Rig up

Drilling and Remarks:

RUR

RECORD

Cased _____ in., _____ ft.

Sand _____

Gas _____

Oil _____

Total Depth _____

PRODUCTION

1st 24 hrs. Nat. _____

1st 24 hrs. after shot _____

Gas _____ Cu. Ft.

Dry Hole _____

Abandoned _____

Date

FEB 14 1945

19

S. J. LEWIS

Scout

Kansas

Pool Name ZenithMap No. 47 Sec. 1 Twp. 24 R. 11WWell No. 5 McNickleTranswestern


Company

COMPLETED

Contractor

C E L NW NW

SECTION PLAT

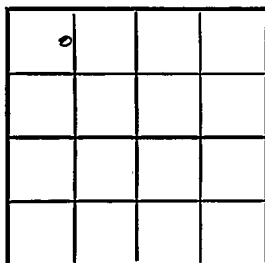660 Ft. from N. Line Ft. from S. Line Ft. from E. Line990 Ft. from W. Line

Stafford

Elev. 1807Location Rig up

Drilling and Remarks:

Via 1a 3721540 3722Pump 80 oil +
30% Water 1st42 0/2

RECORD

Cased in., ft.Sand Gas Oil Total Depth 3736

PRODUCTION

1st 24 hrs. Nat. 1st 24 hrs. after shot Gas Cu. Ft.Dry Hole Abandoned

Date

APR 11 1945

19

S. J. LEWIS

Scout