


Section 1 Township 24 Range 12WWell No. #1 AllenCompany Ben Brack Oil

NORTH

WEST

EAST

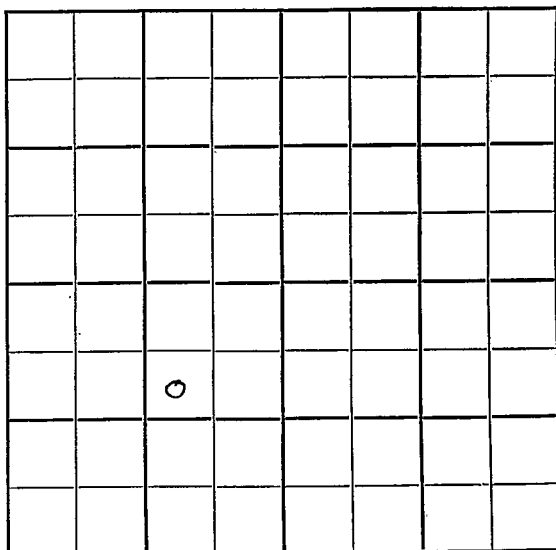

SOUTH

Stafford

KANSAS

Sec. 1 Twp. 24 R. 12 W

Well No. # 4 Allen Farm

Ben Brack Oil Company

Stafford Pool Contractor


990 Ft. from N. Line

 Ft. from S. Line

990 Ft. from E. Line

 Ft. from W. Line

SW NE SW

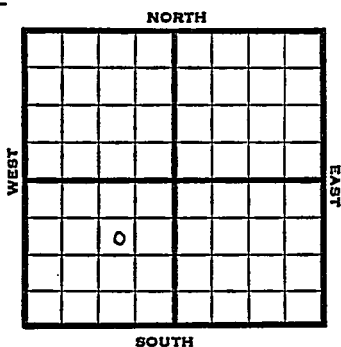

1951 Elev. 1851 REPORT

9/5 Location

10/31 Spud 8-24-51

Oil Well TD 3811

8" @ 292

• Lans. 3444 Viola 3809-11


5" @ 3809 TD 3811

S/1 boph Comp. 3000 bopd

COMPLETED

J. E. TYRA

County Stafford State Kansas
 Sec. 1 (Blk.) 24 (Sur.) 12W Map No.
 Operator Ben Brack Oil
 Well No. 4 Farm Allen
 Elev. 1851 Location SW NE SW

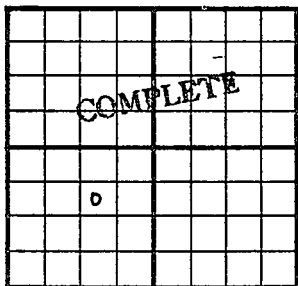

990 Ft. From N Line SW
990 Ft. From E Line Quarter
 Ist. Report
 Completion OCT 31 1951
 Remarks Stafford Pool

Spudding Date 8-24-51

Drilg. Data Oil well TD 3811
8" @ 292 Lams. 3444 Viola 3809-11
5" @ 3809 TD 3811 S/ 1 boph
Comp. 3000 bopd

J. E. TYRA