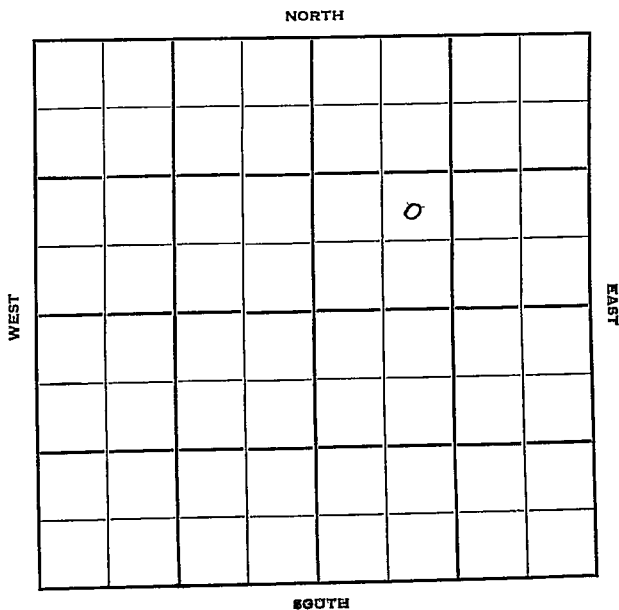


Section 1 Township 24 Range 12WWell No. #3 Allen "A"Company Ben Brack

Stafford KANSAS

Sec. 1 Twp. 24 R. 12W

Well No. #3 Allen "A" Farm ☒

Ben Brack Company

Stafford Pool Contractor


Ft. from N. Line

990' Ft. from S. Line

Ft. from E. Line

990' Ft. from W. Line

NE SW NE

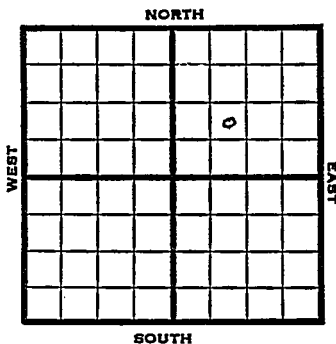

1951 Elev. 1847' REPORT

8/8 Location
11/14 Spud 8-7-51
Oil Well TD 3782
8" @ 3420
Anhy 618 Br. Lime 3399
Ians. 3420 Viola 3766-75
5" @ 3766 TD 3782
1000 A 3000 A S/ 9 BO 8 BW
13 hr. 1500 A S/ 45 BOPD
P/ 40 BOPD
Comp. 26 BOPD 78% wtr.

COMPLETED

County **Stafford** State **Kansas**

Sec. 1 (Blk. 24) (Sur. 12W) Map No. _____
(Twp. 24) (Rge. 12W)

Operator **Ben Brack** n

Well No. 3 Farm Allen "A"

Elev.	1847	Location	NE SW NE
-------	------	----------	----------

[illegible]

990 Ft. From S Line NE

990 Ft. From W Line Quarter

1st. Report **AUG 8 1951**

Completion _____


Remarks

Spudding Date _____

Drlg. Data Stafford Pool

Location

~~J. E. TYRA~~

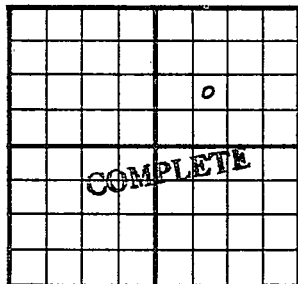County Stafford State KansasSec. 1 (Blk.
Twp.) 24 (Sur.
Rge.) 12W Map No.Operator Ben BrackWell No. 3 Farm Allen "A"Elev. 1847 Location NE SW NE

990 Ft. From S Line NE

990 Ft. From W Line Quarter

1st. Report

Completion NOV 14 1951Remarks Stafford PoolSpudding Date 8-7-51Drlg. Data Oil well. TD 37828" @ 280 Anhy 618 Br. lime 3399Lens. 3420 Viola 3766-75 5" @ 3766TD 3782 1000 A 3000 A S/ 9 bo 8 bw13 hr. 1500 A S/ 45 bopd P/ 40 bopdComp. 26 bopd 78% water

J. E. TYRA