

Well No. # 1 English Reid

Company Welch & Olsson

NORTH

WEST

EAST

0

SOUTH

Stafford

KANSAS

Sec. 1 Twp. 24 R. 15W

Well No. #1 ^{Reid}~~English~~ Farm

Welch & Olsson

Company

Welch & Olsson

Contractor

Wildcat


990 Ft. from N. Line

Ft. from S. Line

Ft. from E. Line

990 Ft. from W. Line

SE NW SE

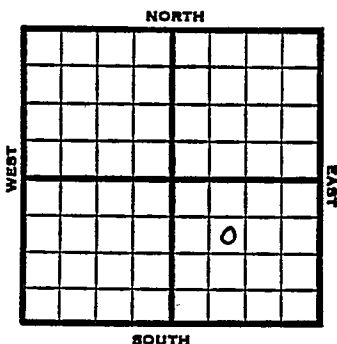

1953 Elev. 1996: REPORT

6/17	Loc.
------	------

6/24 MI

7/1	8 th @ 220 Dr1g. 2558:
-----	--------------------------------------

7/8 Heeb 3513 Br 1i 3650 Lans 3661
 B KC 3910 V 4020 Arb. 4116

7/15 | Spud 6-24-53

D&A

TD 4130

8" @ 220

Heeb 3513, Br lime 3650, Lans 3661,

B KC 3910, Viola 4020, Simp 4071,
Arb. 4116

TD 4130

D&A

ABANDONED

Kansas

Map No. _____ Sec. 1 Twp. 24 R. 15WWell No. 1 Reid_____
Welch & Olsson Company_____
CORRECTION Contractor

SE NW SE

SECTION PLAT

990 Ft. from N. Line Ft. from S. Line Ft. from E. Line990 Ft. from W. Line

Stafford County

Location _____

Rig up _____

Drilling and Remarks:

Reported

#1 English

RECORD

Cased _____ in., _____ ft.

Sand _____

Gas _____

Oil _____

Total Depth _____

PRODUCTION.

1st 24 hrs. Nat. _____

1st 24 hrs. after shot _____

Gas _____ Cu. Ft.

Dry Hole _____


Abandoned _____

Date

JUN 4 1953 19

J. G. McGEHEE

Scout

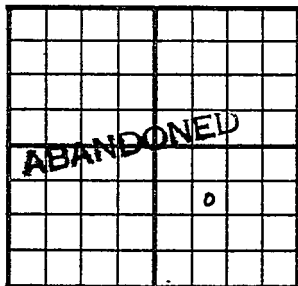County Stafford State KansasSec. 1 (Blk.
Twp.) 24 (Sur.
Rge.) 15W Map No.Operator Welch & OlssonWell No. 1 Farm ReidElev. 1996 Location SE NW SE990 Ft. From N Line SE990 Ft. From W Line Quarter1st. ReportCompletion JUL 15 1953Remarks WildcatWelch & Olsson - Contr.Spudding Date 6-24-53Drlg. Data D & A TD 41308" @ 220 Heeb. 3513 Br. lime 3650Lans. 3661 B KC 3910 Viola 4020Simp. 4071 Arb. 4116 TD 4130D & A