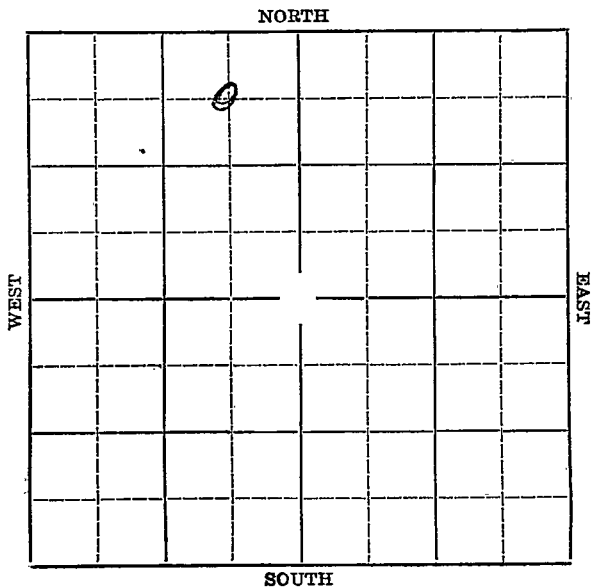
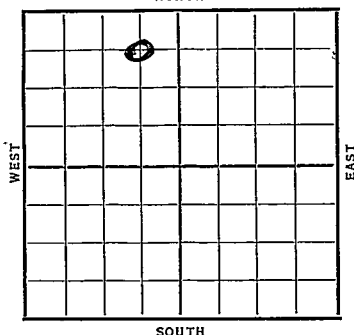


Section 10 Township 24 Range 4-WWell Number #2-BrownCompany Olson & Shell

Sec. 10 Twp. 24 R. 4WWell No. #2 Brown. FarmOlson & Shell Company

NORTH

660' Ft. from N. Line Ft. from S. Line Ft. from E. Line663' Ft. from W. Line~~1936~~

REPORT

9/23 Location.

10/1 12" @ 305'. WOC.

10/8 Drlg. 2048'.

10/15 No report.

10/22 Drlg. 2745'.

10/29 Drlg. 3278'.

11/6 Chat 3279 7" @ 3338 Rust

11/12 T. D. 3369. Flow 310 oil 8%
water 8 hrs. 2000 acid. No Test

11/18 Chat 3279 T. D. 3369

2000 acid. Pot. 1713 oil
plus 24% water.COMPLETED

Map No. 40 Sec. 10 Twp. 24 R. 4WWell No. 2. BrownOlson & Skell Company

Contractor

SECTION PLAT

	0		

660 Ft. from N. Line

_____ Ft. from S. Line

663 Ft. from E. Line

_____ Ft. from W. Line

FIRST REPORT

Location ✓

Rig up _____

Drilling and Remarks:

RECORD

Cased _____ in., _____ ft.

Sand _____

Gas _____

Oil _____

Total Depth _____

PRODUCTION

1st 24 hrs. Nat. _____

1st 24 hrs. after shot _____

Gas _____ Cu. Ft.

Dry Hole _____

Abandoned _____

Date

SEP 23 1936

19

S. J. LEWIS Scout

Map No. 40 Sec. 10 Twp. 24 R. 4WWell No. 2 BrownOlson & Shell Company

Contractor

SECTION PLAT

	0		

660 Ft. from N. Line

_____ Ft. from S. Line

663 Ft. from E. Line

_____ Ft. from W. Line

COMPLETED

Location _____

Rig up _____

Drilling and Remarks:

Chas 82792000 acidP & 1713 oilplus 24% water

RECORD

Cased _____ in., _____ ft.

Sand _____

Gas _____

Oil _____

Total Depth 3369

PRODUCTION

1st 24 hrs. Nat. _____

1st 24 hrs. after shot _____

Gas _____ Cu. Ft.

Dry Hole _____

Abandoned _____

Date

NOV 18 1936 19

S. J. LEWIS

Scout