


Reno
24 4W

Map No. KANSAS Sec. 10 Twp. 24 R. 4W

Well No. 1 - St. Banky Farm
Phillips et al Company

 Ft. from N. Line
660 Ft. from S. Line
660 Ft. from E. Line
 Ft. from W. Line

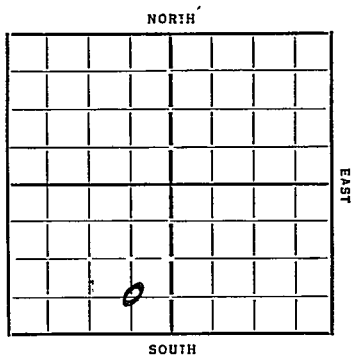

Elev. 1467

Date 1935 REPORT

8/14 B. R.
8/22 15" 270 WOC.
8/29 dly 2560
9/6 " 2992
10/3 T C 3312
10/10 _____
10/17 Chat 3312
 T D 3375
 1000 acid
 137 Oil
 194 Wtu

COMPLETED

KANSAS

Map No. 40 Sec. 10 Twp. 24 R. 4W

Well No. 1 - St. Bank

Phillips et al Company

Contractor

FIRST REPORT

SECTION PLAT

..... Ft. from N. Line

660 Ft. from S. Line

660 Ft. from E. Line

..... Ft. from W. Line

	0		

FIRST REPORT

Location.....

Rig up.....

Drilling and Remarks:

BR

RECORD

Cased.....in.,ft.

Sand.....

Gas.....

Oil.....

Total Depth.....

PRODUCTION

1st 24 hrs. Nat.....

1st 24 hrs. after shot.....

Gas..... Cu. Ft.

Dry Hole.....

Abandoned.....

Date

8-14-35 192

ORVAL MANSCHRECK Scout

