


Reno

Form 51-5M-5-34-Palace

Map No. KANSAS Sec. 10 Twp. 24 R. 4W

Well No. 1- Carmichael Farm _____
Texas Co. Company _____

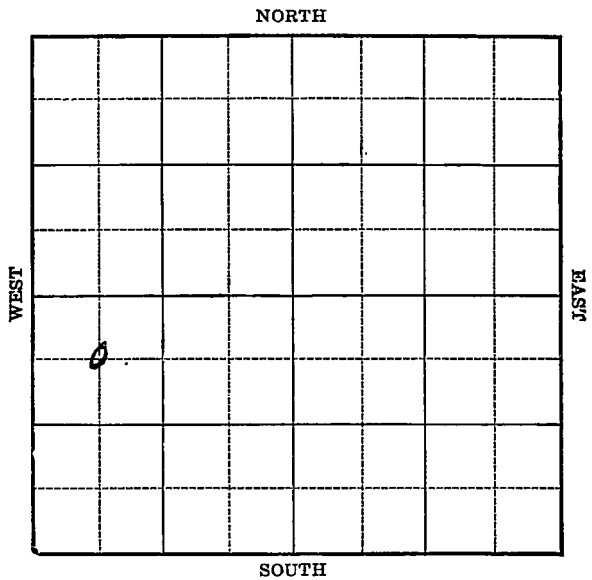

Location _____
Drilling Remarks _____

Rig Up _____
Drilling Remarks _____

RECORD

Cased _____ in. _____ ft.
Sand _____
Gas _____
Oil _____
Total Depth _____


PRODUCTION

1st 24 hrs. Nat. _____
1st 24 hrs. after shot _____
Gas _____ cu. ft. _____
Dry Hole _____
Abandoned _____

Keno

Map No. KANSAS Sec. 10 Twp. 24 R. 4W
Well No. 1- Carmichael Farm
Type Co. Company

660 Ft. from N. Line
 Ft. from S. Line
 Ft. from E. Line
660 Ft. from W. Line

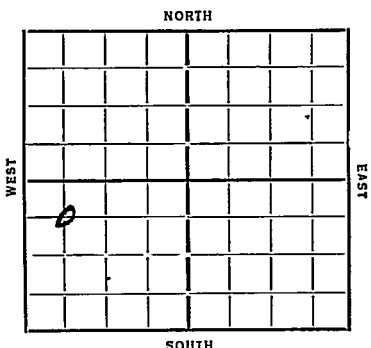

Date 7/25

REPORT

3/13 Cellar
3/21 Rig
3/28 Rgh
4/4 15 1/2 289 Bly cement
4/11 Bly 2200
4/18 " 3144
4/26 T C 3295 8" 3300 Rust
5/2 3335 5 M Huc Oil 3342
Inc 3365-70 flow 100 Bbls
14 hrs.
5/8 Chat 3295 + 7 3388
253 oil 25 Water

COMPLETED

Map No. 40 Sec. 10 Twp. 24 R. 4W

Well No. 1—Carmichael

Texas Company Company

Contractor

FIRST REPORTS

SECTION PLAT

660 Ft. from N. Line

_____ Ft. from S. Line

_____ Ft. from E. Line

660 Ft. from W. Line

0			

Location _____

Rig up _____

Drilling and Remarks:

RECORD

Cased _____ in., _____ ft.

Sand _____

Gas _____

Oil _____

Total Depth _____

PRODUCTION

1st 24 hrs. Nat. _____

1st 24 hrs. after shot _____

Gas _____ Cu. Ft.

Dry Hole _____

Abandoned _____

Date

3-13-35 192 ORVAL MANNSCHRECK Scout

KANSAS

Map No. 40 Sec. 10 Twp. 24 R. 4W
 Well No. 1- Carmichael
Texas Co Company

Contractor

COMPLETED

SECTION PLAT

660 Ft. from N. Line
 _____ Ft. from S. Line
 _____ Ft. from E. Line
660 Ft. from W. Line

0			

Location _____

Rig up _____

Drilling and Remarks:

RECORD

Cased _____ in _____ ft.

Sand Chat 3295

Gas _____

Oil _____

Total Depth 3388

PRODUCTION

1st 24 hrs. Nat. _____

1st 24 hrs. after shot _____

Gas _____ Cu. Ft.

Dry Hole _____

Abandoned _____

Date

5-8-35 192ORVAL MANNSCHRECK
Scout