

Form 51-5M-5-34-Palace
Map No. **KANSAS** Sec. 10 Twp. 24 R. 4W
Well No. 1 Carmichael Farm
Rose Spring Oil Co et al Company
NORTH


Rose Springs Rly Co et al Company

NORTH

TEST 1

EAST

SOUTH

[illegible]

Cased_____in. _____ft.
Sand_____
Gas_____
Oil _____
Total Depth_____


[The page contains horizontal dashed lines for writing.]

1st 24 hrs. Nat. _____
1st 24 hrs. after shot _____
Gas _____ cu. ft. _____
Dry Hole _____
Abandoned _____

Reno

Map No. KAN 34 Sec. 10 Twp. 24 R. 4WWell No. 1 Carmichael Farm
Rose Spring Oil Co etc Company

NORTH

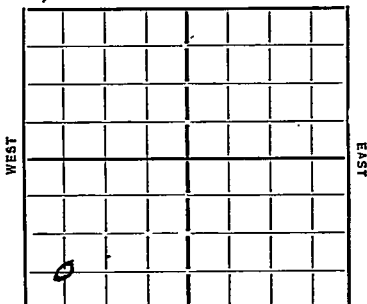

WEST

EAST

SOUTH

Ft. from N. Line

660 Ft. from S. Line

Ft. from E. Line

660 Ft. from W. Line

Date

REPORT

7/9/54
10/3/ Moving in
11/8
11/15 Ponds
11/22 Spud
11/28 Dlg 530 12 1/2 268
12/6 " 1850
12/13 " 2730 NCL 2597
12/21 Chrt 3293 Run 7" 3307
12/27 Rust
1/3/55 Log tools
1/10 1/17 — 1/24 — 1/31 —
2/7 Dlg 3379
2/14 Run 5" liner 3294
2/21
2/28 3385 HFO.
3/7 flow 280 24 hrs.
3/13 Chrt 3293 TD 3385
 524 Bbls.

COMPLETED

Map No. 40 Sec. 10 Twp. 24 R. 4WWell No. 1-CarmichaelRose Spring Oil & Gas Co. Inc. Company

Contractor

FIRST REPORTS

SECTION PLAT

 Ft. from N. Line660 Ft. from S. Line Ft. from E. Line660 Ft. from W. Line

0			

Location Rig up

Drilling and Remarks:

Moving in

RECORD

Cased in., ft.Sand Gas Oil Total Depth

PRODUCTION

1st 24 hrs. Nat. 1st 24 hrs. after shot Gas Cu. Ft.Dry Hole Abandoned

Date

10-31-34 19ORVAL MANNSCHRECK
Scout

Map No. 40 Sec. 10 Twp. 24 R. 4W

Well No. 1—Carmichael
Rose Spring Reys Company

Contractor

COMPLETED

SECTION PLAT

Ft. from N. Line

660 Ft. from S. Line

Ft. from E. Line

660 Ft. from W. Line

0			

Location

Rig up

Drilling and Remarks:

524 ftk

RECORD

Cased in. ft.

Sand Chat 3293

Gas

Oil

Total Depth 3385

PRODUCTION

1st 24 hrs. Nat.

1st 24 hrs. after shot

Gas Cu. Ft.

Dry Hole

Abandoned

Date

ORVAL MANNSCHRECK

3-13-35 192 Scout