

Reno

KANSAS

SECTION 10 TOWNSHIP 21 RANGE 6 W

WELL NO. #1 Haines

COMPANY T & M Oil

NORTH

WEST

EAST

0							

SOUTH

Reno

KANSAS

SEC. 10	TWP. 24	R. 6W
------------	------------	----------

WELL NO.

#1 Haines

FARM

COMPANY

T&M Oil

CONTRACTOR

Tom Allan

WILDCAT


Ft. from N. Line

Ft. from S. Line

Ft. from E. Line

Ft. from W. Line

NW NW NW

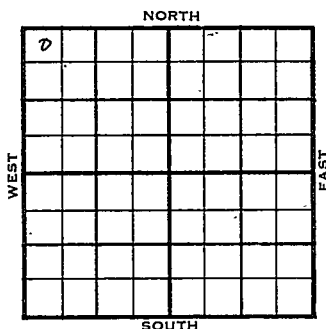

Sun Ac P

1955	ELEVATION 1557'	REPORT
------	--------------------	--------

11-23 MIR

12-14 Comm. 11-23-55
 8 5/8" @ 170/140
 DST 4063-80 op 1 hr. rec. 17' mud
 1050#
 D&A
 BL. 2942
 L. 2969 - 2970
 BKC 3357
 C. 3538
 M. 3632 - 3640
 K. 3802 - 3803
 Dolo 3970
 Mq. Sh 4007
 Viola 4035 - 4037
 Sd. 4064- 4065
 A. 4149 - 4150
 TD 4171'

ABANDONED

County Pano Elev. _____
 Sec. 10 Twp. 24 Rge. 6W
 Company T & M OIL
 Farm Name Haines No. 1

TOPS	DEPTH	LOG	DATUM	Loc. in Sec.
Anb.				NW NW NW
Tr.				
H.				
Tr.				
Dg.				
BL.				
L.				Geol. _____
K.C.				Contr. _____
B.K.C.				<u>Tom Allan</u>
Ce.				Pool _____
C.				<u>Wildcat</u>
M.				
M.				
K.				
Mz.				
Mo.				
V.				
S.				
S.				
A.				
R.				
Pe.				
G.				
T.D.				

Loc. in Sec.

NW NW NW

Geol.

Contr.

Tom Allan

Pool

Wildcat

NOV 23 '55

FIRST REPORT

Date Comm.

Sun Ac P

M I R

Co.

Lse.

No.

Sec.

T.

R.

County Reno Elev. 1557
 Sec. 10 Twp. 24 Rge. 6W
 Company T & M Oil
 Farm Name Haines No. 1

TOPS	DEPTH	LOG	DATUM	Loc. in Sec.
Anh.				NW NW NW
Tr.				
Tr.				
Dg.				
BL.	<u>2942</u>		<u>1385</u>	
L.	<u>2969</u>	<u>2970</u>	<u>1413</u>	
K.C.				Geol.
B.K.C.	<u>3357</u>		<u>1800</u>	Contr.
Ce.				Tom Allan
C.	<u>3538</u>		<u>1981</u>	
M.	<u>3632</u>	<u>3640</u>	<u>2083</u>	
M.				Pool
K.	<u>3802</u>	<u>3803</u>	<u>2246</u>	Wildcat
Mz.				
Mq. <u>Do/o</u>	<u>3970</u>		<u>2413</u>	
<u>Mq 56</u>	<u>4007</u>		<u>2444</u>	
<u>Viola</u>	<u>4035</u>	<u>4037</u>	<u>2480</u>	
S. <u>sd</u>	<u>4064</u>	<u>4065</u>	<u>2508</u>	
A	<u>4149</u>	<u>4150</u>	<u>2593</u>	
R.				
Pe.				
G.				
T.D.	<u>4171</u>			



Date Comm. 11-23-55 DEC 14 1955

8 5/8" @ 170/140 DST 4063-80 open

1 hr. rec. 17' mud 1050#

D & A