

# KANSAS

Form 51-5M-7-39-Palace


Stafford

Section 10 Township 24 Range 11-W

Well No. #2 Banker "A"

Company Transwestern

NORTH Zenith Pool

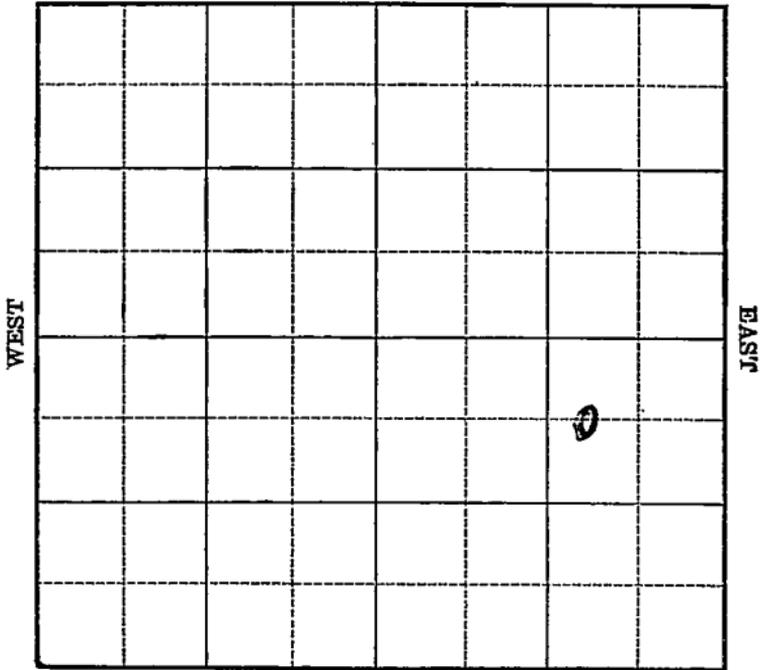

SOUTH

Sec. 10 Twp. 24 R. 11-W

Well No. #2 Banker "A" Farm \_\_\_\_\_

Transwestern Company

(Zenith)


660 Ft. from N. Line

\_\_\_\_\_ Ft. from S. Line

990 Ft. from E. Line

\_\_\_\_\_ Ft. from W. Line

**Elev. 1811**

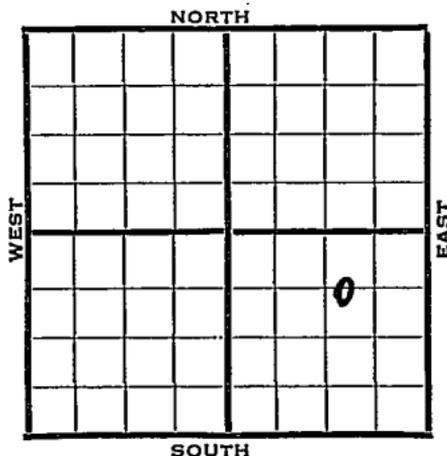

1940	REPORT
3/13	Location
3/28	"
4/4	"
4/12	"
4/18	Surface hole.
4/26	10" - 240' Drlg. 2000'
5/2	Drlg. 3241'
5/9	Misener 3722' S.O. Viola 3753 to 3808 T.D. Run pipe .
5/16	7" - 3722' Bailing.
5/23	Flow 17 bbls. per hour by heads.
5/29	6000 acid. Testing.
6/5	Viola 3753'
	7" - 3722'
	T.D. 3808'
	6000 acid.
	Bomb potential 2251 bbls.
	<b>COMPLETED</b>

Map No. \_\_\_\_\_ Sec. **10** Twp. **24** R. **11W**

Well No. **2 Banker "A"**

**Transwestern** Company

Contractor

**FIRST REPORT  
C W L NE NE**

**SECTION PLAT**

			0

**660** Ft. from N. Line

\_\_\_\_\_ Ft. from S. Line

**990** Ft. from E. Line

\_\_\_\_\_ Ft. from W. Line

**ZENITH POOL**

Location **X**

Rig up \_\_\_\_\_

Drilling and Remarks:

**RECORD**

Cased \_\_\_\_\_ in., \_\_\_\_\_ ft.

Sand \_\_\_\_\_

Gas \_\_\_\_\_

Oil \_\_\_\_\_

Total Depth \_\_\_\_\_

**PRODUCTION**

1st 24 hrs. Nat. \_\_\_\_\_

1st 24 hrs. after shot \_\_\_\_\_

Gas \_\_\_\_\_ Cu. Ft.

Dry Hole \_\_\_\_\_

Abandoned \_\_\_\_\_

Date

**MAR 13 1940** 19

**S. J. LEWIS**

Scout

Map No. 47 Sec. 10 Twp. 24 R. 11W

Well No. 2 Banker "A"

Transwestern Company

CORRECTION Contractor

**SECTION PLAT**

**C W L NE SE**

660 Ft. from N. Line

\_\_\_\_\_ Ft. from S. Line

990 Ft. from E. Line

\_\_\_\_\_ Ft. from W. Line

**ZENITH POOL**


Location \_\_\_\_\_

Rig up \_\_\_\_\_

Drilling and Remarks:

**Reported**

**C W L NE NE**

**RECORD**

Cased \_\_\_\_\_ in., \_\_\_\_\_ ft.

Sand \_\_\_\_\_

Gas \_\_\_\_\_

Oil \_\_\_\_\_

Total Depth 777

**PRODUCTION**

1st 24 hrs. Nat. \_\_\_\_\_

1st 24 hrs. after shot \_\_\_\_\_

Gas \_\_\_\_\_ Cu. Ft.

Dry Hole \_\_\_\_\_

Abandoned \_\_\_\_\_

Date

MAR 25 1940<sub>19</sub>

S. J. LEWIS Scout

Form 26—200 Bks.—1-40—Palace Stafford

Map No. 47 Sec. 10 Twp. 24 R. 11W

Well No. 2 Banker "A"

Transwestern Company

Contractor

**COMPLETED**

**SECTION PLAT**

**C W L N E S E**

660 Ft. from N. Line

\_\_\_\_\_ Ft. from S. Line

990 Ft. from E. Line

\_\_\_\_\_ Ft. from W. Line

			o

**ZENITH POOL**

Location \_\_\_\_\_

Rig up \_\_\_\_\_

Drilling and Remarks:

*Vida 3753*  
*7" 03722*  
*6000 acid*  
*Bom & Pot.*  
*2251*

**RECORD**

Cased \_\_\_\_\_ in., \_\_\_\_\_ ft.

Sand \_\_\_\_\_

Gas \_\_\_\_\_

Oil \_\_\_\_\_

Total Depth 3808

**PRODUCTION**

1st 24 hrs. Nat. \_\_\_\_\_

1st 24 hrs. after shot \_\_\_\_\_

Gas \_\_\_\_\_ Cu. Ft.

Dry Hole \_\_\_\_\_

Abandoned \_\_\_\_\_

Date

JUN 5 1940

19

S. J. LEWIS

Scout