

Stafford


Form 51-5M-7-39-Palace

Section 10 Township 24 Range 11-W

Well No. #1 H. Hellmann

Company Stanolind

NORTH Zenith Pool

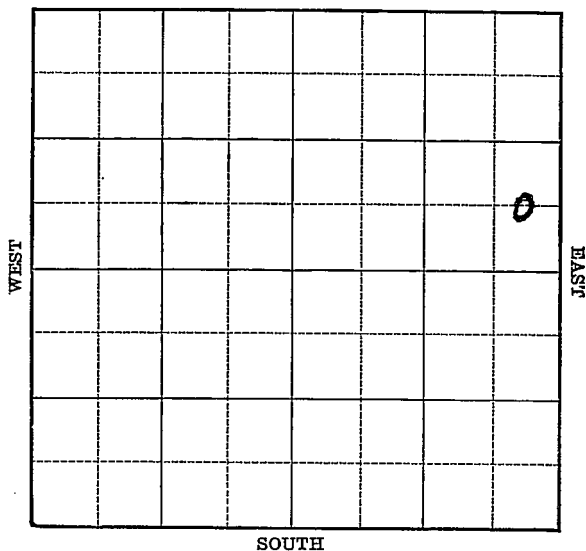

KANSAS


Stafford

Sec. 10 Twp. 24 R. 11-WWell No. #1 H. Hellmann FarmStanolind Company

(Zenith)

 Ft. from N. Line660 Ft. from S. Line330 Ft. from E. Line Ft. from W. Line

Elev. 1810

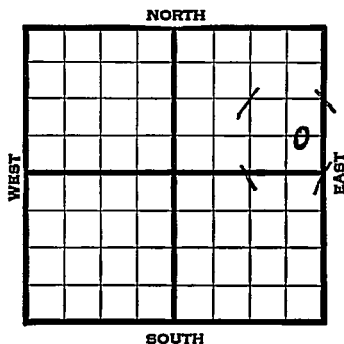

1939	REPORT
11/22	Rotary.
11/29	10" - 255' Drlg. 1685'
12/7	Drlg. 3463'
12/14	Misener 3718' 5½" - 3719'
	T.D. 3740' RUST.
12/21	Drlg. 3772'
12/28	T.D. 3796'
	Flow hourly 113 bbls, 106 bbls,
	95 bbls, & 118 bbls.
	1000 acid. Flow 111 bbls. 1½
	hours thru 1/2" choke.
1940	
1/3	Misener 3718'
	5½" - 3719'
	T.D. 3796'
	1000 acid.
	Bottom hole Bomb potential 8056
	Maximum 3000 bbls.
	COMPLETED

Map No. 47 Sec. 10 Twp. 24 R. 11WWell No. 1 H. HellmannStanolind

Company

Contractor

FIRST REPORTC $E\frac{1}{2}$ SE NE Ft. from N. Line660 Ft. from S. Line330 Ft. from E. Line Ft. from W. Line**ZENITH POOL****SECTION PLAT**

Location Rig up Drilling and Remarks: **Rotary****RECORD**Cased in., ft.Sand Gas Oil Total Depth **PRODUCTION**1st 24 hrs. Nat. 1st 24 hrs. after shot Gas Cu. Ft.Dry Hole Abandoned

Date

NOV 22 1939 19S. J. LEWIS Scout

Map No. 47 Sec. 10 Twp. 24 R. 11WWell No. 1 H. HellmarmStanolind

Company

Contractor

COMPLETED**C E $\frac{1}{2}$ SE NE**

Ft. from N. Line

660 Ft. from S. Line330 Ft. from E. Line

Ft. from W. Line

ZENITH POOL**SECTION PLAT**

Location _____

Rig up _____

Drilling and Remarks:

*Wine 3718.**5 1/2" @ 3719.**1000 acid**Bottom Hole Box**P.Y. 8056.**Maximum 2000***RECORD**

Cased _____ in., _____ ft.

Sand _____

Gas _____

Oil _____

Total Depth 3796**PRODUCTION**

1st 24 hrs. Nat. _____

1st 24 hrs. after shot _____

Gas _____ Cu. Ft.

Dry Hole _____

Abandoned _____

Date

JAN 1 19

S. J. LEWIS Scout