


Section 10 Township 24 Range 11-W

Well No. #2 Banker "D"

Company Transwestern

NORTH Zenith Pool

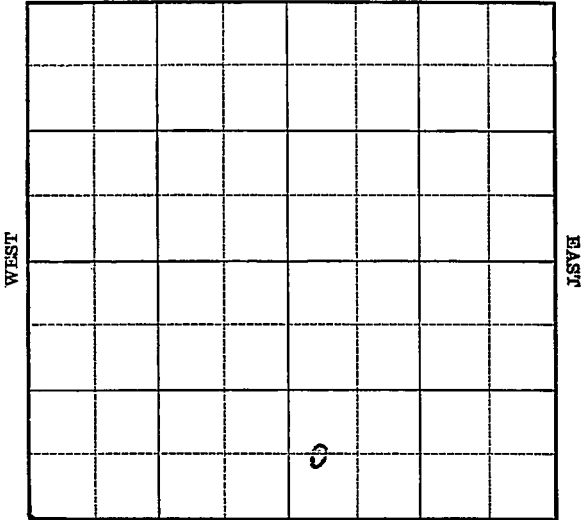

SOUTH

Sec. 10 Twp. 24 R. 11-W

Well No. #2 Banker "D" Farm

Transwestern Company

(Zenith)


_____ Ft. from N. Line

660 Ft. from S. Line

_____ Ft. from E. Line

330 Ft. from W. Line

Elev. 1815

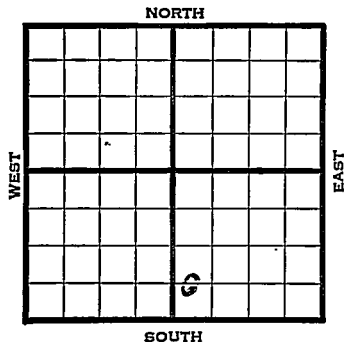

1940	REPORT
10/9	Derrick.
10/17	Drlg. 2350'
10/24	Drlg. 3520'
10/31	Viola 3778½' T.D. 3829' 7" - 3781' RUST.
11/7	Flow 94 oil 1 hour. 4000 acid.
11/13	Viola 3778½'
	7" - 3781'
	T.D. 3829'
	4000 acid.
	Bomb potential 3674 bbls.
	Maximum 3000 bbls.
	COMPLETED

Map No. 47 Sec. 10 Twp. 24 R. 11WWell No. 2 Banker "D"Transwestern

Company

Contractor

FIRST REPORT

C W L SW SE

_____ Ft. from N. Line

660 Ft. from S. Line

_____ Ft. from E. Line

330 Ft. from W. Line

ZENITH POOL

SECTION PLAT

		o	

Location _____

Rig up _____

Drilling and Remarks:

Derrick

RECORD

Cased _____ in., _____ ft.

Sand _____

Gas _____

Oil _____

Total Depth _____

PRODUCTION

1st 24 hrs. Nat. _____

1st 24 hrs. after shot _____

Gas _____ Cu. Ft.

Dry Hole _____

Abandoned _____

Date

OCT 9 1940 19

S. I. LEWIS Scout

Map No. 47 Sec. 10 Twp. 24 R. 11W

Well No. 2 Banker "D"

Transwestern Company

Contractor

COMPLETED

SECTION PLAT

C W L SW SE

 Ft. from N. Line

660 Ft. from S. Line

 Ft. from E. Line

330 Ft. from W. Line

		0	

ZENITH POOL

Location

Rig up

Drilling and Remarks:

Viola 3778 1/2
9" @ 3781
4000 acid
Bom & Pt 3674

Max 3000

RECORD

Cased in., ft.
 Sand
 Gas
 Oil
 Total Depth 3829

PRODUCTION

1st 24 hrs. Nat.
 1st 24 hrs. after shot
 Gas Cu. Ft.
 Dry Hole
 Abandoned

Date

NOV 13 1940 19

S. I. LEWIS Scout