

Stafford


KANSAS

Form 51—5M—7-39—Palace

Section 10 Township 24 Range 11-W

Well No. #2 Heggy

Company Stanolind

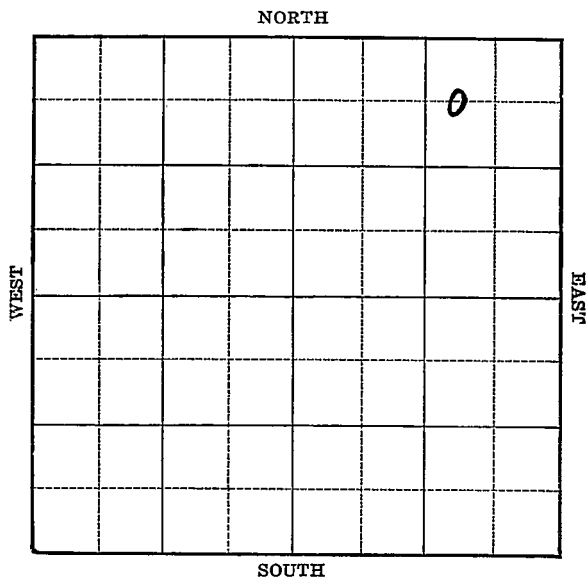

Stafford

KANSAS

Map No. 47 Sec. 10 Twp. 24 R. 11WWell No. 2 Heggy

Stanolind

Company

Contractor

FIRST REPORT

C W L NE NE

660 Ft. from N. Line Ft. from S. Line990 Ft. from E. Line Ft. from W. Line

SECTION PLAT

			6

ZENITH POOL

Location Rig up

Drilling and Remarks:

Loc.

RECORD

Cased in., ft.Sand Gas Oil Total Depth

PRODUCTION

1st 24 hrs. Nat. 1st 24 hrs. after shot Gas Cu. Ft.Dry Hole Abandoned

Date

APR 3 1940 19

S. J. LEWIS Scout

Map No. 47 Sec. 10 Twp. 24 R. 11WWell No. 2 HeggyStanolind

Company

Contractor

COMPLETED

C W L NE NE

660 Ft. from N. Line Ft. from S. Line990 Ft. from E. Line Ft. from W. Line

ZENITH POOL

SECTION PLAT

			6

Location Rig up

Drilling and Remarks:

*Viola 3726**7" C 3728.**3000 acid**Bomb P & 3671**Maximum 3000*

RECORD

Cased in., ft.Sand Gas Oil Total Depth 3790

PRODUCTION

1st 24 hrs. Nat. 1st 24 hrs. after shot Gas Cu. Ft.Dry Hole Abandoned

Date

MAY 8 1940 19S. J. LEWIS Scout