

KANSAS


FORM 51 5M 4-41 PETROL

Stafford

Section 10 Township 24 Range 11-W

Well No. 3 Richardson

Company Porter etal

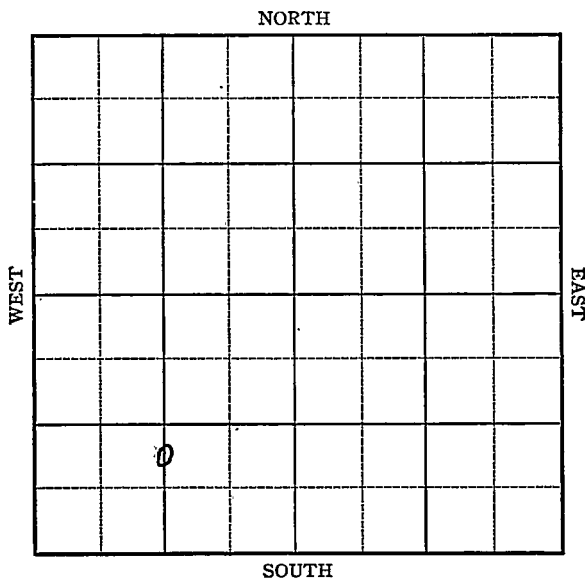

Sec. 10 Twp. 24 R. 11-W

Well No. #3 Richardson Farm

Porter et al Company

(Zenith)


_____ Ft. from N. Line

990 Ft. from S. Line

_____ Ft. from E. Line

1320 Ft. from W. Line

Elev. 1819

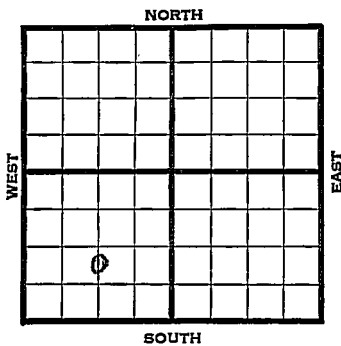

1941	REPORT
7/9	Rotary.
7/17	8" - 260' Drlg. 2000'
7/24	Drlg. 3540'
7/31	Viola 3806-08 TD 5" @ 3807½ RUST.
8/7	TD 3821' 3000 acid.
8/13	Viola 3804'
	5" - 3805½
	3000 acid
	T.D. 3821'
	Bomp. pot. 8467
	Grav. 42.6
	COMPLETED

Map No. 47 Sec. 10 Twp. 24 R. 11WWell No. 3 RichardsonPorter etal

Company

Contractor

FIRST REPORT**SECTION PLAT**C N L S $\frac{1}{2}$ SW Ft. from N. Line990 Ft. from S. Line Ft. from E. Line1320 Ft. from W. Line

ZENITH POOL

Location Rig up

Drilling and Remarks:

Rotary

RECORDCased in., ft.Sand Gas Oil Total Depth **PRODUCTION**1st 24 hrs. Nat. 1st 24 hrs. after shot Gas Cu. Ft.Dry Hole Abandoned

Date

JUL 9 1941

19

S. J. LEWIS Scout

