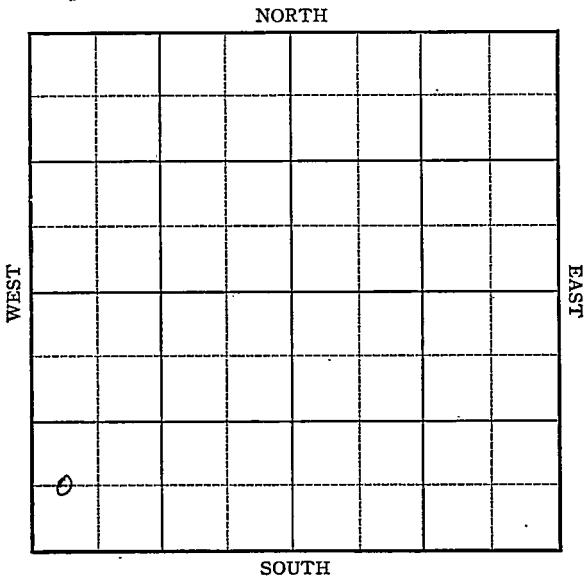
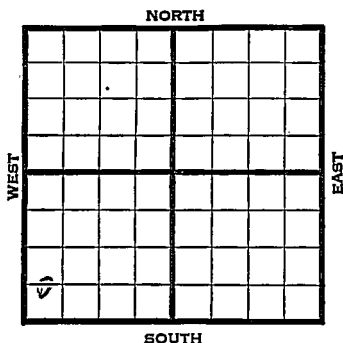


Section 10 Township 24 Range 11-WWell No. #4 Richards onCompany Porter etal
(Zenith)

[illegible]

Map No. 47 Sec. 10 Twp. 24 R. 11WWell No. 4 RichardsonPorter etal Company**FIRST REPORT** Contractor

C W L SW SW

 Ft. from N. Line660 Ft. from S. Line Ft. from E. Line330 Ft. from W. Line**ZENITH POOL****SECTION PLAT**

o			

Location XRig up Drilling and Remarks: **RECORD**Cased in., ft.Sand Gas Oil Total Depth **PRODUCTION**1st 24 hrs. Nat. 1st 24 hrs. after shot Gas Cu. Ft.Dry Hole Abandoned

Date

JUL 23 1941 19 S. J. LEWIS Scout

Map No. 47 Sec. 10 Twp. 24 R. 11WWell No. 4 RichardsonPorter etal

Company

COMPLETED

Contractor

SECTION PLAT

C W L SW SW

 Ft. from N. Line660 Ft. from S. Line Ft. from E. Line330 Ft. from W. Line

ZENITH POOL

o			

Location Rig up

Drilling and Remarks:

*Vida 3807**5" @ 3811**3000 acid**Bom & P 2631**42 6/8***RECORD**Cased in., ft.Sand Gas Oil Total Depth 3841**PRODUCTION**1st 24 hrs. Nat. 1st 24 hrs. after shot Gas Cu. Ft.Dry Hole Abandoned

Date

AUG 27 1941S. J. LEWIS

Scout