

KANSAS

Stafford


Form 51-5M-7-40-Palace

Section 10 Township 24 Range 11-W

Well No. #6 Richardson

Company Stanolind

NORTH Zenith Pool

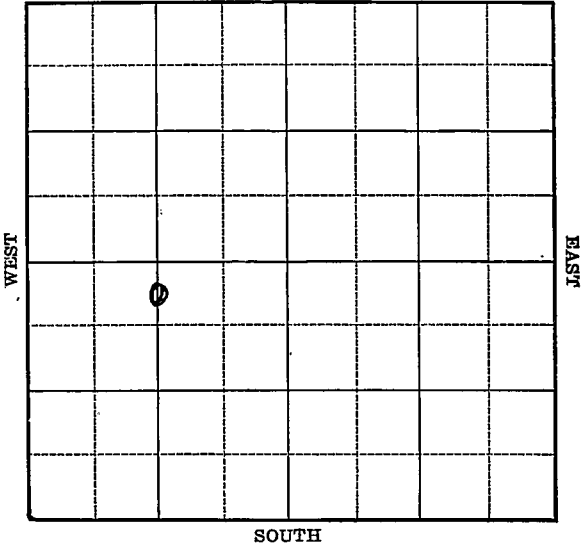

Sec. 10 Twp. 24 R. 11-W

Well No. #6 Richardson Farm

Stanolind Company

(Zenith)


330 Ft. from N. Line

_____ Ft. from S. Line

1320 Ft. from E. Line

_____ Ft. from W. Line

Elev. 1822

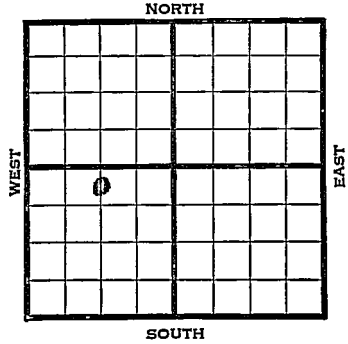

1941	REPORT
3/12	Location
3/20	Derrick.
3/27	Rigging up.
4/3	8" - 279' Drlg. 2055'
4/10	Drlg. 3526'
4/18	Viola 3794' 5" - 3796'
	T.D. 3820' RUST.
4/23	Viola 3794'
	5" - 3796'
	T.D. 3820'
	3000 acid.
	Bomb potential 3820 bbls.
	Maximum 3000 bbls.
	42.6 Gravity
	COMPLETED

Map No. 47 Sec. 10 Twp. 24 R. 11WWell No. 6 RichardsonStanolind

Company

Contractor

FIRST REPORT

SECTION PLAT

C N L SW

330 Ft. from N. Line

_____ Ft. from S. Line

1320 Ft. from E. Line

_____ Ft. from W. Line

	o		

ZENITH POOL

Location X

Rig up _____

Drilling and Remarks:

RECORD

Cased _____ in., _____ ft.

Sand _____

Gas _____

Oil _____

Total Depth _____

PRODUCTION

1st 24 hrs. Nat. _____

1st 24 hrs. after shot _____

Gas _____ Cu. Ft.

Dry Hole _____

Abandoned _____

Date

MAR 12 1941 19S. J. LEWIS Scout

