


FORM 51 5M 4-41 PETROL

Section 10 Township 24 Range 11-W

Well No. #7 Richardson

Company Stanolind

NORTH Zenith Pool

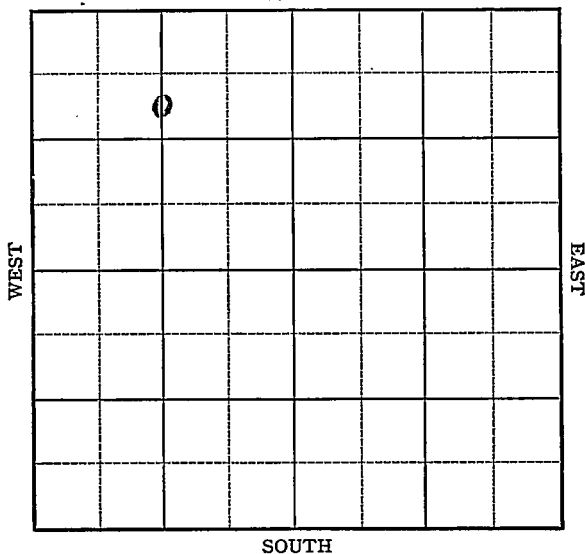


Sec. 10 Twp. 24 R. 11-WWell No. #7 Richardson FarmStanolind

Company

(Zenith)

990 Ft. from N. Line Ft. from S. Line1320 Ft. from E. Line Ft. from W. Line

Elev. 1814

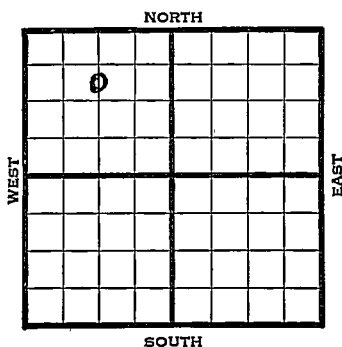

1941	REPORT
4/9	Location
4/18	R.U.R.
4/24	8" - 269' Drilg. 2560'
5/1	Viola 3738 -56' T.D. Run csg.
5/8	5" - 3740' Coring 3775'
5/15	" " " "
5/22	T.D. 3781' C.O.
5/28	T.D. 3800' 3000 acid.
	Testing.
6/4	Viola 3738'
	5" - 3740'
	T.D. 3800'
	10,000 acid.
	Pump 73 oil & 41 water.
	42.6 Gravity
	COMPLETED

Map No. 47 Sec. 10 Twp. 24 R. 11W

Well No. 7 Richardson

Stanolind

Company

FIRST REPORT

Contractor


SECTION PLAT

C S L N $\frac{1}{2}$ NW
990 Ft. from N. Line

 Ft. from S. Line

1320 Ft. from E. Line

 Ft. from W. Line

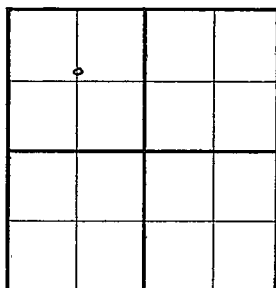

ZENITH POOL

Location X

Rig up

Drilling and Remarks:

RECORD

Cased in., ft.

Sand

Gas

Oil

Total Depth

PRODUCTION

1st 24 hrs. Nat.

1st 24 hrs. after shot

Gas Cu. Ft.

Dry Hole

Abandoned

Date

APR 9 1941 19

S. J. LEWIS

Scout

Map No. 47 Sec. 10 Twp. 24 R. 11WWell No. 7 RichardsonStanolind

Company

Contractor

COMPLETED

SECTION PLAT

C S L N $\frac{1}{2}$ NW990 Ft. from N. Line

Ft. from S. Line

1320 Ft. from E. Line

Ft. from W. Line

ZENITH POOL

Location _____

Rig up _____

Drilling and Remarks:

*Vista 3735**5" 3740**10000 acid**Pump 7800 & 41 Water**42 6 1/2*

RECORD

Cased _____ in., _____ ft.

Sand _____

Gas _____

Oil _____

Total Depth 3800

PRODUCTION

1st 24 hrs. Nat. _____

1st 24 hrs. after shot _____

Gas _____ Cu. Ft.

Dry Hole _____

Abandoned _____

Date

JUN 4 1941S. J. LEWIS

Scout