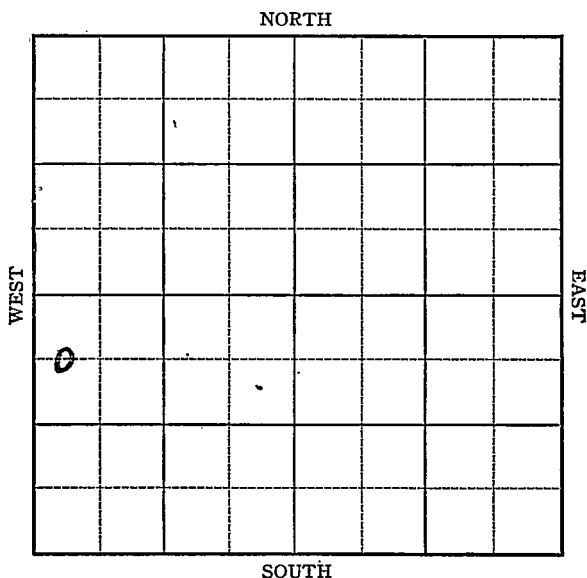


Stafford

KANSAS

Section 10 Township 24 Range 11WWell No. 10 RichardsonCompany Stanolind

KANSAS

Stafford

Sec. 10 Twp. 24 R. 11-W

Well No. #10 Richardson Farm

Stanolind Company
(Zenith) NORTH


_____Ft. from N. Line

1980 Ft. from S. Line

Ft. from E. Line

330 Ft. from W. Line

Elev. 1819

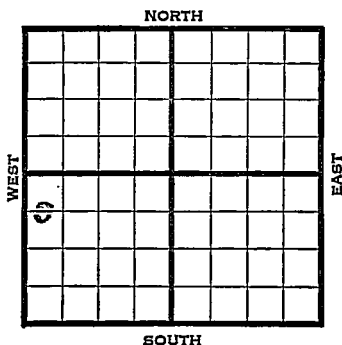[illegible]

Map No. 47 Sec. 10 Twp. 24 R. 11WWell No. 10 RichardsonStanolind

Company

FIRST REPORT

Contractor

SECTION PLAT

C W L NW SW

 Ft. from N. Line1980 Ft. from S. Line Ft. from E. Line330 Ft. from W. Line

D			

ZENITH POOL

Location XRig up Drilling and Remarks:

RECORD

Cased in., ft.Sand Gas Oil Total Depth

PRODUCTION

1st 24 hrs. Nat. 1st 24 hrs. after shot Gas Cu. Ft.Dry Hole Abandoned

Date

JUN 1 8 1941 19S. J. LEWIS Scout

KANSAS

Map No. 47 Sec. 10 Twp. 24 R. 11WWell No. 10 Richardson

Stanolind

Company

COMPLETED

Contractor

C W L NW SW

SECTION PLAT

o			

Ft. from N. Line

1980

Ft. from S. Line

Ft. from E. Line

330

Ft. from W. Line

ZENITH POOL

Location

Rig up

Drilling and Remarks:

*Vs/a 3799**5" @ 3801**3000 acid**Born & P 81445**42-6-96*

RECORD

Cased _____ in., _____ ft.

Sand _____

Gas _____

Oil _____

Total Depth 3829

PRODUCTION

1st 24 hrs. Nat. _____

1st 24 hrs. after shot _____

Gas _____ Cu. Ft.

Dry Hole _____

Abandoned _____

Date

JUL 30 1941

19

S. J. LEWIS

Scout